



47800 Sugarbush Rd,
New Baltimore, MI 48047

REQUEST FOR PROPOSAL

REQUEST FOR PROPOSAL
Project Number:

1000



EXISTING DDC - ALC

ANCHOR BAY
SCHOOL DISTRICT

**NALDRETT
ELEMENTARY
SCHOOL**

REQUEST FOR PROPOSAL

EXISTING
DDC - ALC

REQUEST FOR PROPOSAL

Date: 3/13/2021

MOO1

Naldrett Elementary

Item #	Area Served	Legacy Control's Page Number	Notes
RTU-1	Speech / Supply		Include (3) zones w/ RH coils
RTU-2	Media Center		Include (2) zones w/ RH coils
RTU-3	Main Office Area	25 of 27	Include (2) zones w/ RH coils
RTU-2 (GYM)	Gym & MP		
UV's	Unit Ventilators (qty of 27)	18 of 27	
Radiant Panels	Varies	21 of 27	qty of 3
Hx	HWS Heat Exchanger	23 of 27	
FCU	Stage (qty of 2)		
FCU	Storage / Corridor (Area B) (qty of 2)		
FCU	Corridor Kindergarten (Area D)		
EF's	Varies		qty of 12
CUH's	Varies		qty of 5
UH's	Varies		qty of 5
FTR	Varies		qty of 2

No.	Description
1	
2	
3	
4	
5	
6	
7	
8	
9	
10	

ANCHOR BAY
SCHOOL DISTRICT

DDC CONTROLS
UPGRADES

NALDRETT
ELEMENTARY
SCHOOL

REQUEST FOR PROPOSAL

EQUIPMENT
SCHEDULE FOR
DDC UPGRADE


REQUEST FOR PROPOSAL

Project Number:

Date: 3/13/2022

M002

D

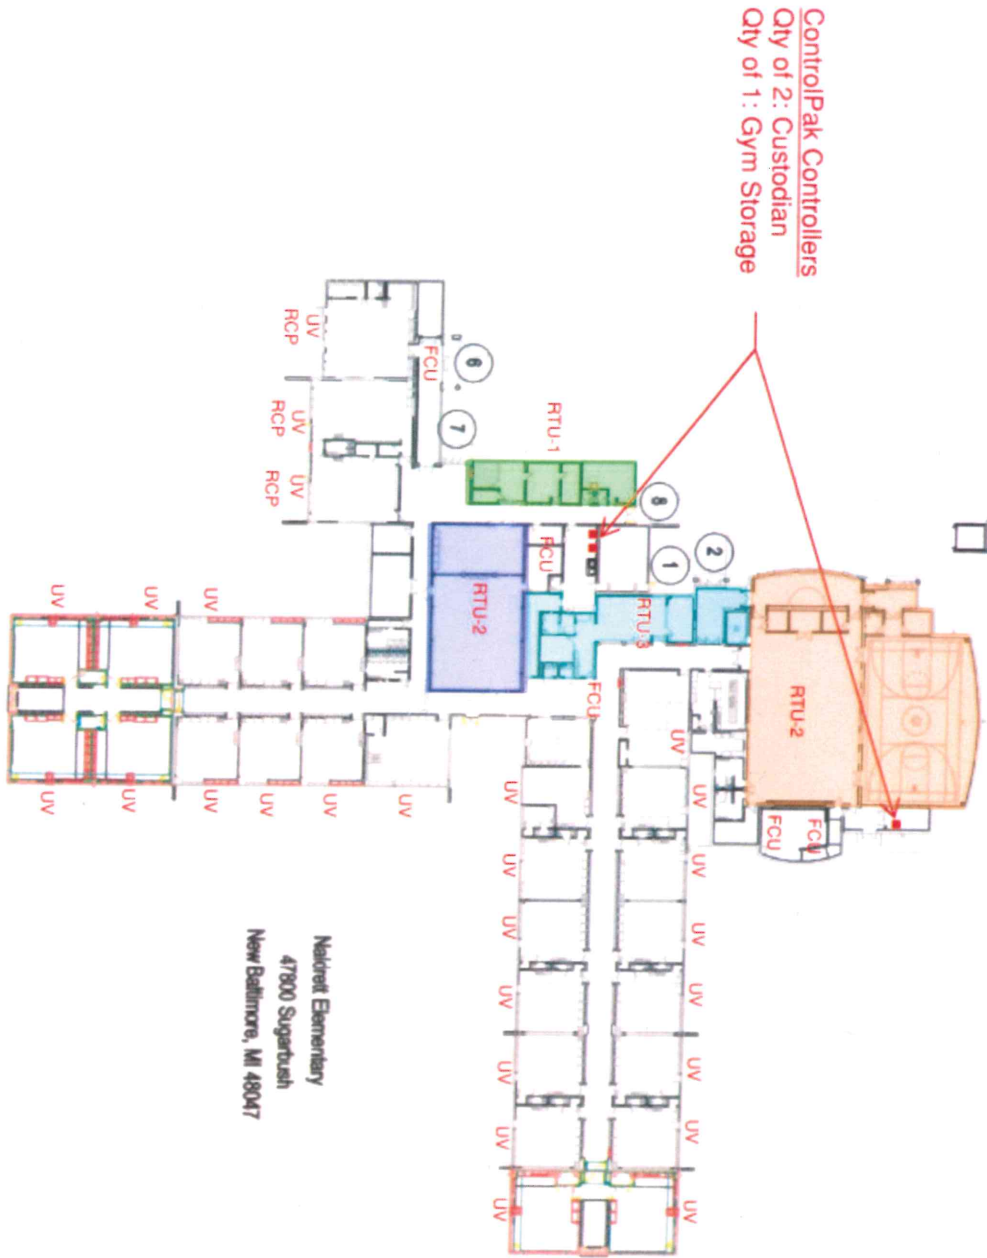

Naldrett Elementary
47800 Sugarbush
New Baltimore, MI 48047

FLOORPLAN FOR DDC UPGRADE

No.	Description
1	
2	
3	
4	
5	
6	
7	
8	

ANCHOR BAY
SCHOOL DISTRICT
DDC CONTROLS
UPGRADES

NALDRETT
ELEMENTARY
SCHOOL


REQUEST FOR PROPOSAL
FLOORPLAN
FOR DDC
UPGRADE

REQUEST FOR PROPOSAL
Project Number:
Date: 3/13/202

M003

OWNER:
 ANCHOR BAY SCHOOL DISTRICT
 CONSULTING ENGINEERS
PETER BASSO ASSOCIATES, INC.
 ARCHITECT PLANNERS INTERIORS
FRENCH ASSOCIATES
 CONSTRUCTION MANAGERS
 BARTON MALOW
 MECHANICAL CONTRACTOR:
 DUAL TEMP MECHANICAL & REFRIGERATION

DDC SYSTEM ARCHITECTURE

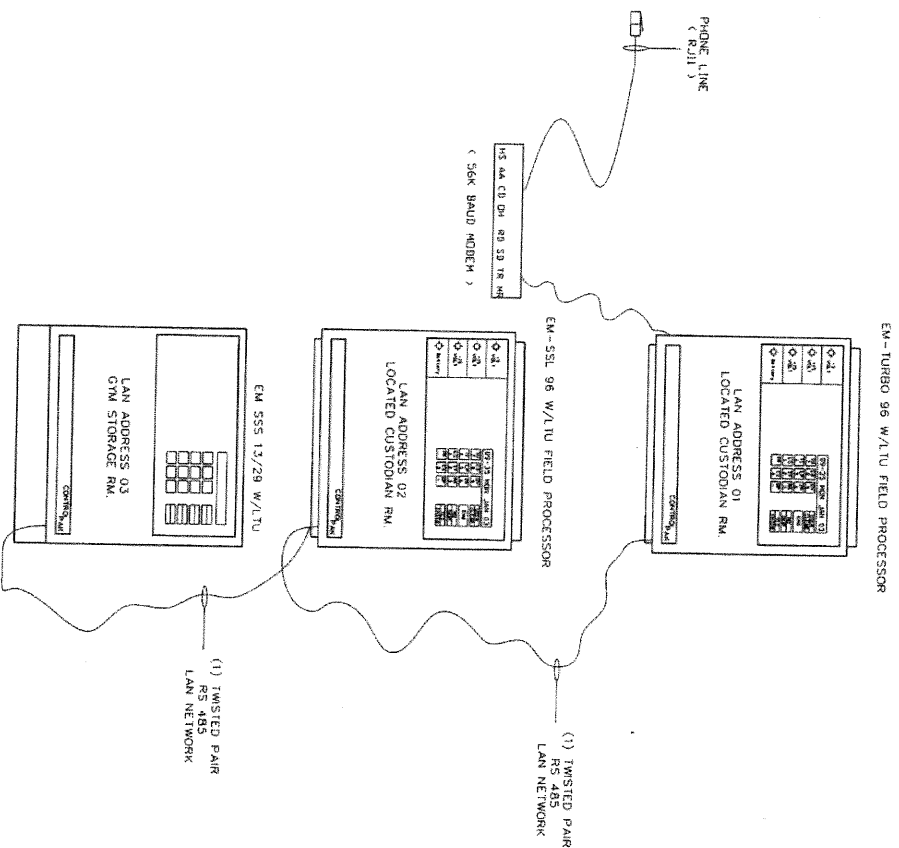

ANCHOR BAY SCHOOL DISTRICT
 NALDRETT ELEMENTARY SCHOOL
 ADDRESS: 47800 SPOONBUSH, NEW BALTIMORE, MI 48041



SYSTEM
 SYSTEM ARCHITECTURE/INDEX

C^T CONTROLLED TEMPERATURE INC.


1897 WEST DRIVE - WALKER LANE MOH 48390 TEL (248) 665-0506

FILE NAME: TITLE BLOCK.dwg
 DRAWN BY: KOS DATE: 10-22-01 JOB NO. 00-138


INDICATES EXTERNALLY POWERED
SENSOR. 510 OHM RESISTOR WIRE
PARALLEL WITH R & S.

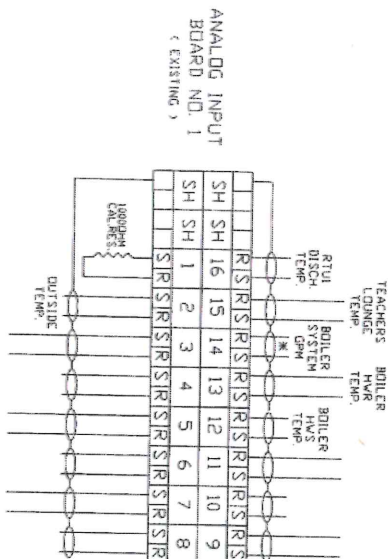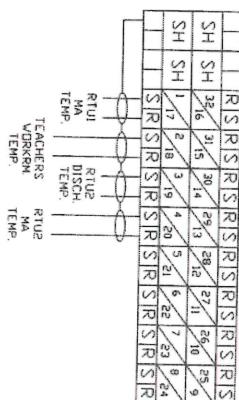ANALOG INPUT
BOARD NO. 1
(EXISTING)


ANALOG INPUT BOARD NO. 2

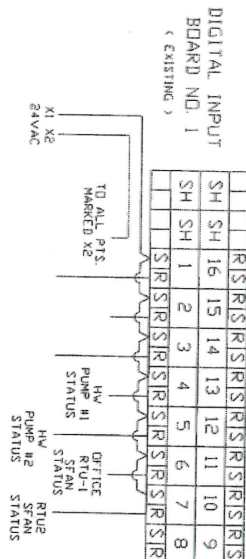


DIGITAL INPUT
BOARD NO. 1
(EXISTING)

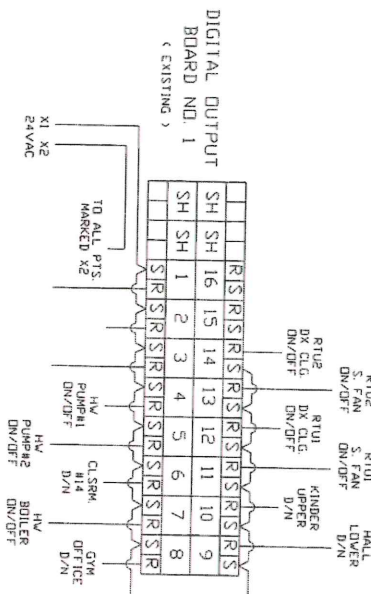



DIGITAL OUTPUT
BOARD NO. 1
(EXISTING)

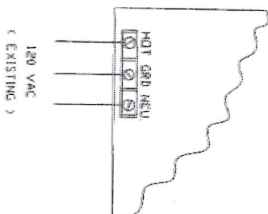

120 VAC
EXISTING

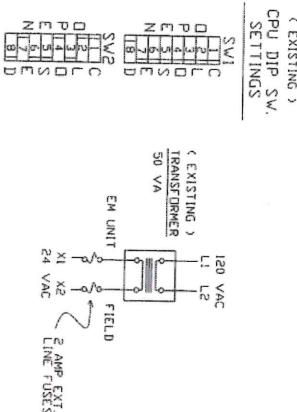

(EXISTING)
CPU DIP SW
SETTINGS

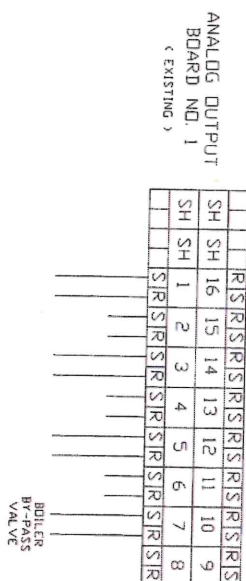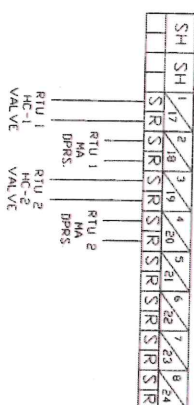ANALOG OUTPUT
BOARD NO. 1
(EXISTING)ANALOG OUTPUT
BOARD NO. 2

CONTROLLED TEMPERATURE INC.
1897 BEST DRIVE • VALLEJO LAKE MICH 48390 TEL. (313) 669-0050

ANCHOR BAY SCHOOL DISTRICT

DEAN ALBERT ELMENBAR
 C EM TURBO-96 TERMINAL CONNECTIONS (LAN-0)

NEW BALTIMORE


MICHIGAN

DRAWN BY:	THS	UPDATED DATE:	10-19-01	5-17-94	SHEET 3 OF 14	JOB NO.:	HVAC-329
-----------	-----	---------------	----------	---------	---------------	----------	----------

EM 48/192 WALL UNIT LAYOUT

LOCATED IN BOILER ROOM

FRONT VIEW

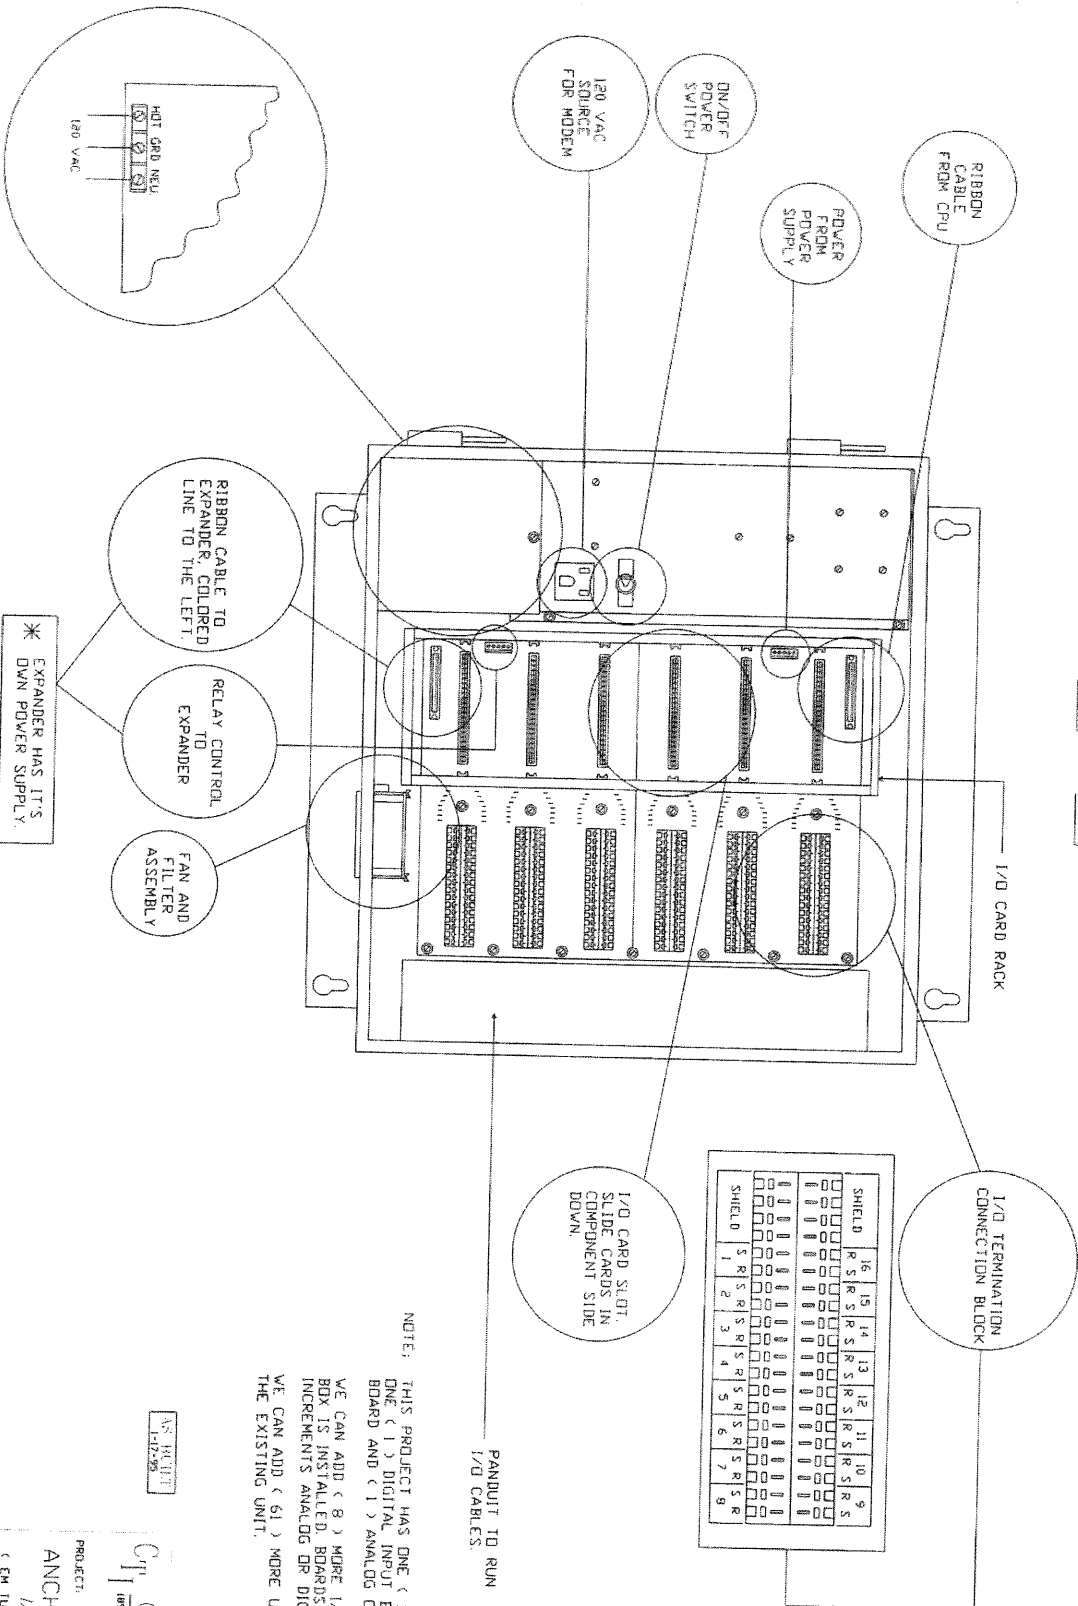

NOTE: THIS PROJECT HAS ONE (1) ANALOG INPUT BOARD, ONE (1) DIGITAL INPUT BOARD, (1) DIGITAL OUTPUT BOARD AND (1) ANALOG OUTPUT BOARD IN THE BASE UNIT. WE CAN ADD (8) MORE I/O BOARDS IF AN EXPANDER BOX IS INSTALLED. BOARDS ARE ADDED IN (16) POINT INCREMENTS ANALOG OR DIGITAL. WE CAN ADD (61) MORE UNITS AND NETWORK THEM TO THE EXISTING UNIT.

AS NOTED
1-17-94

CONTROLLED TEMPERATURE INC.
1007 WEST DRIVE, VALLEY LAKE, ILL. 60050 TEL. (312) 669-0500

PROJECT: ANCHOR BAY SCHOOL DISTRICT

DEAN ANDRETTI ELEMENTARY

NEW BATTIMORE
(EM 48/192 I/O CARD AND MOTHERBOARD LAYOUT)

DRAWN BY: S-17-94 SHEET 4 OF 14 JOB NO. HVAC-325

MICHIGAN

SEQUENCE OF OPERATION

BOILER HEATING SYSTEM CONTROL

THE PERIMETER HOT WATER HEATING (HWH) LOOP CIRCULATING PUMPS CP-1 AND CP-2 CIRCULATING PUMP MOTOR STARTER HAND/OFF/AUTO SWITCHES WILL BE PLACED IN THE "AUTO" POSITION. BOILERS B-1 THROUGH B-3 CONTROL SWITCHES WILL BE PLACED IN THE "ON" POSITION.

ONE PERIMETER HWH CIRCULATING PUMP (CP-1 OR CP-2) WILL BE DESIGNATED AS THE "LEAD" PUMP AND THE OTHER PUMP WILL BE DESIGNATED AS THE "STAND-BY" PUMP THROUGH OPERATOR COMMAND TO THE CONTROL PAK DDC SYSTEM.

THE BOILER CIRCULATING PUMP ON/OFF STATUS WILL BE PROVEN TO THE CONTROL PAK DDC SYSTEM BY MEANS OF THE PUMP MOTOR CURRENT SWITCH. IF A "LEAD" PUMP HAS FAILED AS SENSED BY THE PUMP MOTOR CURRENT SWITCH, A CONTROL PAK DDC SYSTEM WILL AUTOMATICALLY ENERGIZE THE "STAND-BY" PUMP AND INDICATE A FAILURE ALARM. ONLY ONE PUMP WILL RUN AT ANY TIME. THE "LEAD" PUMP AND "STAND-BY" PUMP WILL BE ALTERNATED EVERY 1000 HOURS THROUGH THE CONTROL PAK DDC SYSTEM.

WHEN THE OUTSIDE AIR TEMPERATURE IS AT OR BELOW 60 DEGREES F. AS DETERMINED BY THE OUTSIDE AIR SENSOR, THE CONTROL PAK DDC SYSTEM WILL START THE "LEAD" HEATING CIRCULATING PUMP.

WHEN THE OUTSIDE AIR TEMPERATURE IS 60 DEGREES OR BELOW THE BOILER MASTER SEQUENCING PANEL WILL BE ACTIVATE THE BOILER CONTROL CIRCUITS AND FULLY MODULATE EACH BOILER IN SEQUENCE TO MAINTAIN THE HOT WATER HEATING SUPPLY TEMPERATURE. EACH INDIVIDUAL BOILER WILL NOT FIRE UNLESS FLOW IS PROVEN BY ITS FLOW SWITCH.

THE HWH SUPPLY TEMPERATURE WILL BE RESET BASED ON OUTSIDE AIR TEMP. RESET SCHEDULE PRE-PROGRAMMED IN THE BOILER MASTER SEQUENCING PANEL.

WHEN THE OUTSIDE AIR TEMPERATURE RISES ABOVE 60 DEGREES F. THE BOILER SYSTEM WILL DE-ACTIVATE.

THE HEATING HOT WATER FLOW METER THROUGH DDC WILL MODULATE THE BY-PASS CONTROL VALVE TO MAINTAIN CONSTANT FLOW THROUGH THE BOILERS.

DURING UNOCCUPIED HOURS WHEN THE OUTSIDE AIR TEMPERATURE IS BELOW 50 F. THE CONTROL PAK DDC SYSTEM WILL INITIATE BOILER LOW TEMPERATURE ALARM AND OR BOILER NO FLOW ALARM VIA PHONE MODEN TO THE OWNERS THIRD PARTY MONITORING DISPATCH COMPANY.

MECHANICAL BOILER ROOM HEATING AND VENTILATION CONTROL

ROOM THERMOSTAT WILL MODULATE HEATING VALVE TO MAINTAIN ROOM TEMP. UPON A CALL FOR HEATING FROM THE ROOM THERMOSTAT THE FAN WILL BE CYCLED ON. WHEN THE ROOM THERMOSTATS SETPOINT IS REACHED, FAN WILL BE CYCLED OFF. AQUASTAT WILL BE WIRED TO THE FAN TO PREVENT FAN OPERATION WHEN HEAT IS NOT AVAILABLE.

WHENEVER MECHANICAL ROOM TEMPERATURE RISES ABOVE 80 F. THE T-STAT WILL MODULATE THE HIGH AND LOW VENTILATION DAMPERS TOWARDS OPEN TO MAINTAIN ROOM TEMPERATURE.

BILL OF MATERIALS

ITEM #	QTY.	PART NUMBER	MANUFACTURER	DESCRIPTION
1	1	TK1001-403	BARBER COLMAN	PNEUMATIC THERMOSTAT SET @ 68 F.
2	2	TS8201	BARBER COLMAN	IMMERISION SENSOR
3	2	AT215	BARBER COLMAN	STAINLESS STEEL WELL
4	2	MK3121	BARBER COLMAN	DAMPER ACTUATOR 8 TO 13# SPRING
5	1	VK9223-603-5-14	BARBER COLMAN	4" TWO-WAY VALVE 300 GPM @ 20' HD
6	1	VK9211-201-4-04	BARBER COLMAN	1/2" TWO WAY VALVE 85 GPM @ 15' HD
7	1	CP8551	BARBER COLMAN	TRANSDUCER 4 TO 20 MA IN 3 TO 13# DUT
8	3	MR801/C	AIR PRODUCTS & CONTROLS	SPLIT ISOLATION RELAY (24 VAC OR 115 VAC COIL)
9	2	H708	VERIS INDUSTRIES	CURRENT SENSOR
10	1	AT9DAC-1	JOHNSON CONTROLS	AQUASTAT SET @ 100 F.
11	1	PI08C-7	JOHNSON CONTROLS	P.E. RELAY SET @ 5#
12	1	24" X 8"	VENT PRODUCTS	FRESH AIR INTAKE DAMPER
13	1	18" X 18"	VENT PRODUCTS	RELIEF AIR DAMPER
14	1	6"	DIETERICH-STANDARD	ANNUBAR INSERTION PROBE
15	1	ABB 500T	KENT-TAYLOR	DIFFERENTIAL PRESSURE TRANSMITTER
16	1	ABB 200R	KENT-TAYLOR	DIGITAL INDICATOR

CONTROL VALVE SCHEDULE

ITEM #	QTY.	PART NUMBER	MANUFACTURER	SIZE	TYPE	GPM	CV	CALC. CV	ΔP FLTD	RANGE #/VDC	SERVICE
1	1	VK9223-603-5-14	BARBER COLMAN	4"	2-WAY	300	145	118	20	8 - 13#	S-R BY-PASS
2	1	VK9211-201-4-04	BARBER COLMAN	1/2"	2-WAY	85	33	333	15	3 - 8#	BLR RM UH
3											
4											

AS BUILT
1-17-95

**NOT INCLUDED IN DDC UPGRADES RFP -
HWS & BOILER CONTROL HAS BEEN
INCLUDED WITH BOILER REPLACEMENT
PROJECT.**

ANCHOR BAY SCHOOL DISTRICT
DEAN NADETTT ELLENBERRY
< SEQUENCE OF OPERATION AND BILL OF MATERIALS >
NEW BALTIMORE
DRAWN BY: THIS
CHECKED BY: 5-17-94
DATE: SHEET 5 OF 14
JOB NO: HVAC-329
MICHIGAN


CONTROLLED TEMPERATURE INC.
1097 WEST DRIVE, VALUED LANE NICH 48390 TEL: (313) 669-0500

ANCHOR BAY SCHOOL DISTRICT
VALDRETT ELEMENTARY SCHOOL
ADDRESS: 47800 SUGARBUSH, NEW BALTIMORE, MI 48041

SYSTEM
BOILER AND HW HEATING CONTROL
LWM ADDRESS 01

CT CONTROLLED TEMPERATURE INC.
1899 WEST BAYVIEW, VALDE LAKE MICH 48390 TEL (248) 669-0590
FILE NAME: BOILERS.dwg
DRAWN BY: KOS DATE: 01-09-01 JOB NO: 00-138

05
PAGE NUMBER

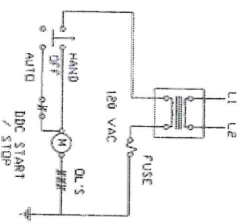

TYPICAL HW PUMP STARTER WIRING

**NOT INCLUDED IN DDC UPGRADES RFP -
HWS & BOILER CONTROL HAS BEEN
INCLUDED WITH BOILER REPLACEMENT
PROJECT.**

SEQUENCE OF OPERATION

THE HOT WATER HEATING (HWH) LOOP CIRCULATING PUMPS CP-1 AND CP-2 CIRCULATING PUMP MOTOR STARTER HAND/OFF/AUTO SWITCHES WILL BE IN THE 'AUTO' POSITION. BOILERS B-1 AND B-2 CONTROL SWITCHES WILL BE PLACED IN THE 'ON' POSITION.

ONE HWH CIRCULATING PUMP (CP-1 OR CP-2) WILL BE DESIGNATED AS THE 'LEAD' PUMP AND THE OTHER PUMP WILL BE DESIGNATED AS THE 'STANDBY' PUMP THROUGH OPERATOR COMMAND TO THE DDC SYSTEM.

THE BOILER CIRCULATING PUMP 'ON/OFF' STATUS WILL BE PROVIDED TO THE DDC SYSTEM BY MEANS OF THE PUMP MOTOR CURRENT SWITCH. IF THE 'LEAD' PUMP HAS BEEN STOPPED BY THE PUMP MOTOR CURRENT SWITCH THE DDC SYSTEM WILL AUTOMATICALLY ENERGIZE THE 'STANDBY' PUMP AND INDICATE THAT THE 'STANDBY' PUMP IS RUNNING. THE 'STANDBY' PUMP WILL BE ALTERNATED EVERY 1000 HOURS THROUGH THE DDC SYSTEM.


WHEN THE OUTSIDE AIR TEMPERATURE IS AT 60°F. OR BELOW THE DDC SYSTEM WILL START THE 'LEAD' CIRCULATING PUMP.


WHEN THE OUTSIDE AIR TEMPERATURE IS 60°F. OR BELOW THE BOILER MASTER SEQUENCING PANEL WILL ACTIVATE OR DE-ACTIVATE THE BOILER CONTROL CIRCUITS AND FULLY MODULATE EACH BOILER INDIVIDUALLY IN ACCORDANCE WITH ITS FLOW IN THE BOILER MASTER SEQUENCE PANEL.

WHEN THE OUTSIDE AIR TEMPERATURE WILL BE RESET BASED ON THE OUTSIDE AIR TEMPERATURE RESET SCHEDULE PRE-PROGRAMMED IN THE BOILER MASTER SEQUENCE PANEL.

WHEN THE OUTSIDE AIR TEMPERATURE RESIS ABOVE 60°F. THE BOILER SYSTEM WILL DE-ACTIVATE.

HEATING HOT WATER FLOW WATER THROUGH DDC WILL MODULATE THE BYPASS CONTROL VALVE TO MAINTAIN CONSTANT FLOW THROUGH THE BOILERS.

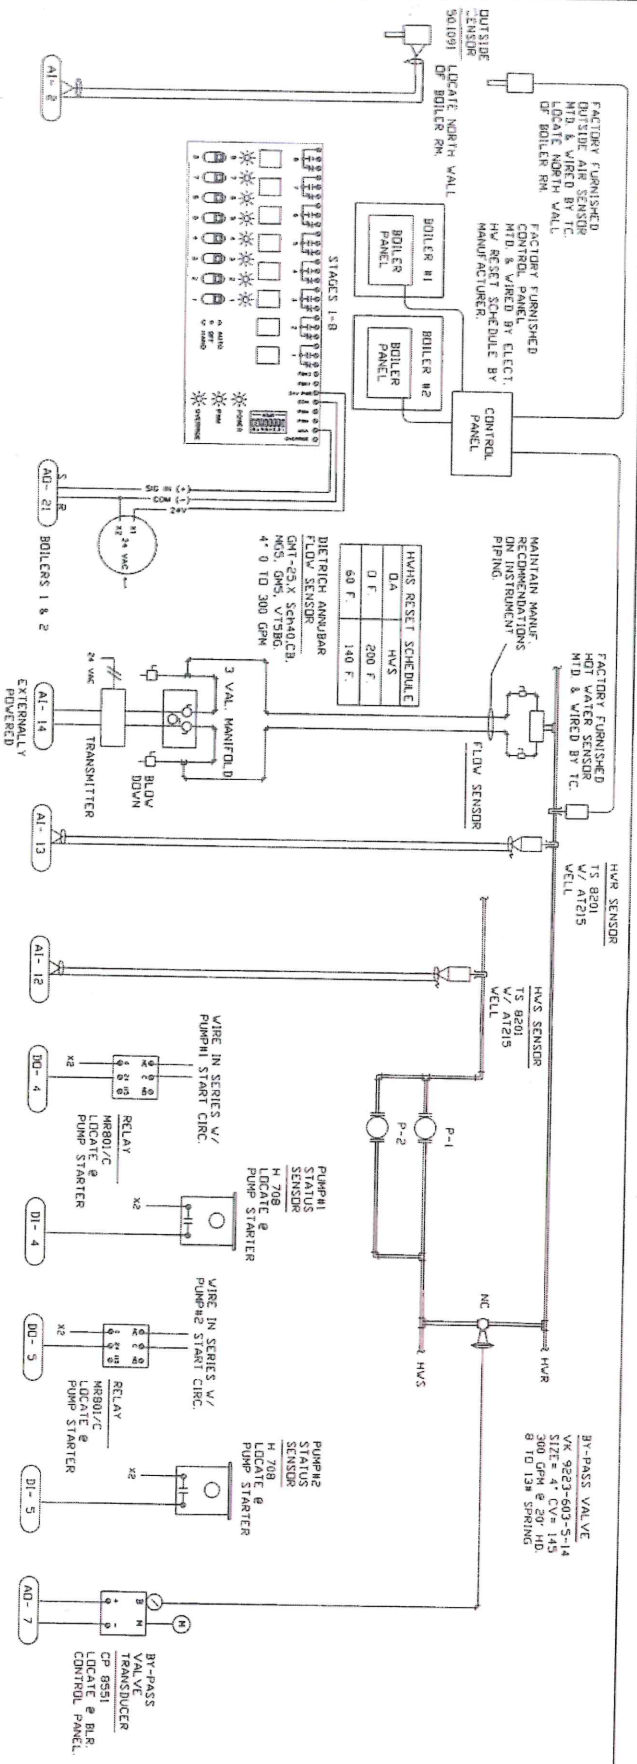


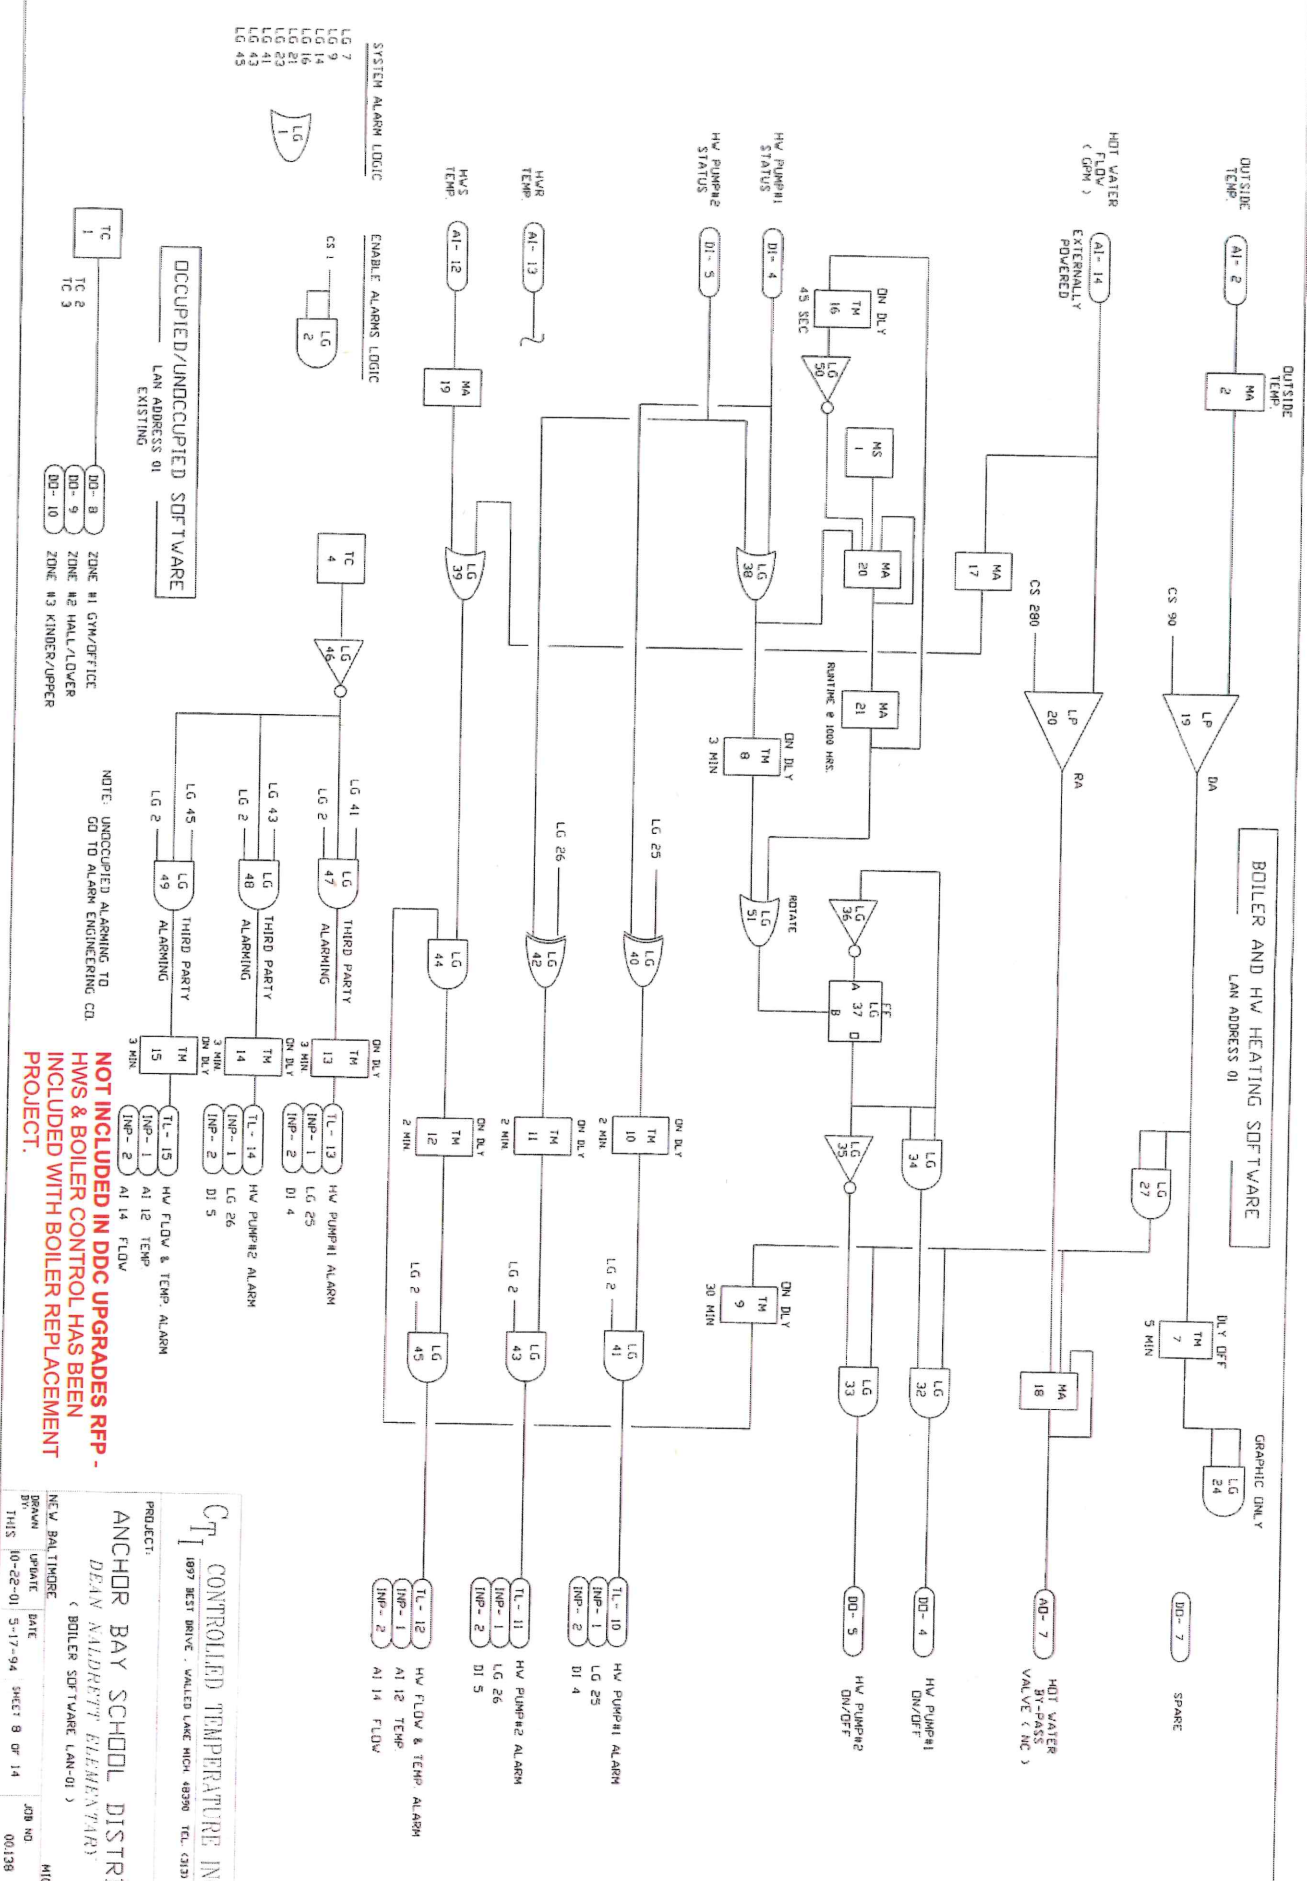

PROJECT: **ANCHOR BAY SCHOOL DISTRICT**
 DEAN ALBERT ELLIOTT
 (BOILER SOFTWARE LAN-01)
 NEW BALTIMORE
 DRAWN BY: 10-22-01
 DATE: 5-17-94
 SHEET: 9 OF 14
 JOB NO: 00128
 MICHAEL

BOILER AND HW HEATING SOFTWARE

LAN ADDRESS 01

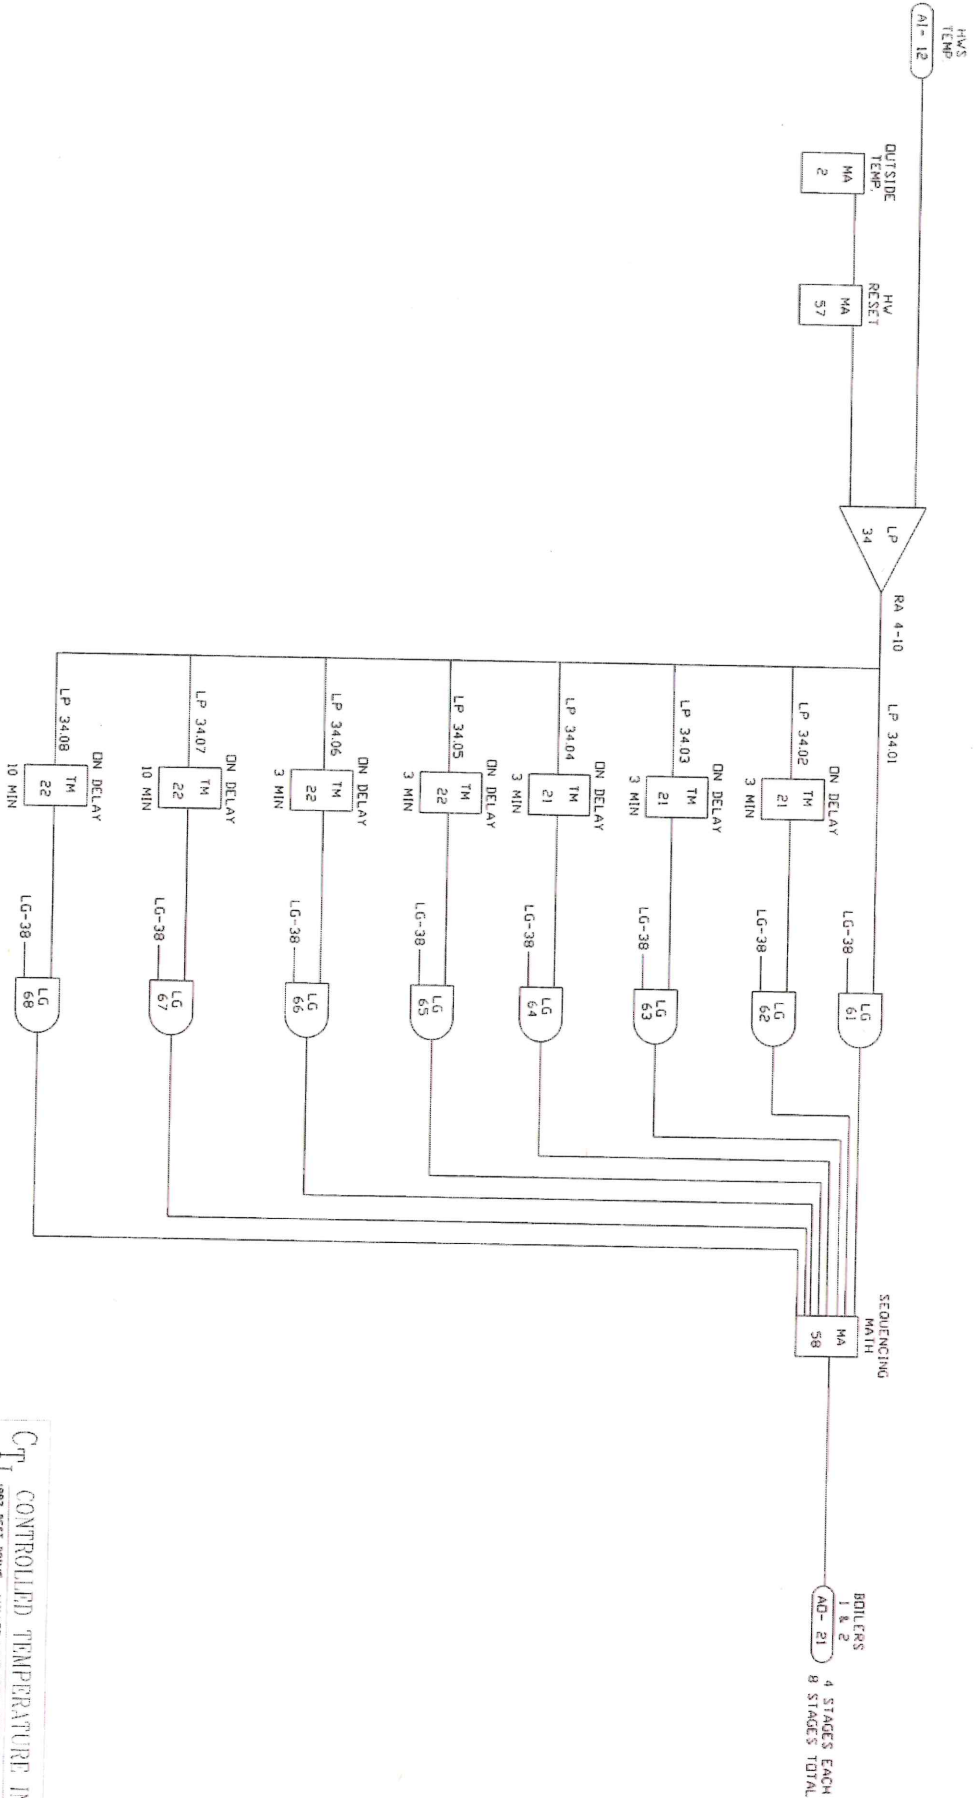

**NOT INCLUDED IN DDC UPGRADES RFP -
HWS & BOILER CONTROL HAS BEEN
INCLUDED WITH BOILER REPLACEMENT
PROJECT.**

CTI CONTROLLED TEMPERATURE INC.
1897 WEST DRIVE, WALKED LAKE MICH 48390 TEL. (313) 663-0500

PROJECT:
ANCHOR BAY SCHOOL DISTRICT
DEAN ANDRETT ELEMENTARY
(BOILER SOFTWARE LAN-01)

NEW BOLT TIGHTEN
DRAWN
DATE
11-11-03
SHEET
JOB NO.
00138
MICHIGAN

RTU #1 & 2 AND UNIT VENTILATOR SEQUENCE OF OPERATION

ROOF TOP UNIT CONTROL

WITH THE SUPPLY FAN MOTOR STARTER HAND/OFF/AUTO SWITCH IN THE 'AUTO' POSITION, THE RTU SUPPLY FAN WILL BE AUTOMATICALLY STARTED AND STOPPED THROUGH THE CONTROL PAK DDC SYSTEM AT THE OCCUPANCY HOUR BASED ON THE PRE-PROGRAMMED OCCUPANCY SCHEDULE.

WHENEVER THE SUPPLY FAN IS STARTED THE OUTSIDE AIR DAMPERS WILL OPEN TO MINIMUM POSITION (ADJUSTABLE) AS PROGRAMMED THROUGH THE DDC SYSTEM.

PROOF OF FLOW STATUS FOR THE SUPPLY FAN WILL BE PROVIDED TO THE CONTROL PAK DDC SYSTEM BY MEANS OF THE SUPPLY FAN MOTOR CURRENT SWITCH.

THE OPTIMUM START PROGRAM WILL DETERMINE THE OPTIMUM START TIME REQUIRED TO ATTAIN DESIRED SPACE TEMPERATURE AT OCCUPANCY TIME. WHEN OUTSIDE AIR TEMPERATURE IS ABOVE 50 DEGREES F., THE OPTIMUM START TIME WILL BE EQUAL TO THE OCCUPANCY TIME.

WHEN THE SYSTEM IS STARTED BY THE OPTIMUM START PROGRAM PRIOR TO THE OCCUPANCY TIME, THE WARM-UP CYCLE PROGRAM WILL FULLY CLOSE THE OUTSIDE AIR DAMPER AND FULLY OPEN THE RETURN AIR DAMPER. WHEN THE WARM-UP CYCLE IS COMPLETED AND DESIRED SPACE TEMPERATURE IS REACHED, THE OUTSIDE AIR DAMPERS WILL OPEN TO MINIMUM POSITION OR AS REQUIRED TO MAINTAIN THE DESIRED TEMPERATURE AS PROGRAMMED BY THE DDC SYSTEM.

THE DISCHARGE AIR SENSOR THROUGH THE DDC WILL CONTROL THE DX COOLING COIL, THE MIXED AIR DAMPERS AND THE HEATING COIL CONTROL VALVE IN SEQUENCE TO MAINTAIN A DISCHARGE TEMPERATURE SETPOINT. THE DISCHARGE AIR TEMPERATURE SETPOINT WILL BE RESET BASED ON SPACE TEMPERATURE FEEDBACK FROM THE SPACE TEMPERATURE SENSOR AND LIMITED BY THE DISCHARGE AIR SENSOR.

DURING THE UNOCCUPIED MODE THE UNIT WILL BE CYCLED WITH THE OUTSIDE AIR DAMPERS CLOSED BASED ON SPACE TEMPERATURE FEEDBACK TO MAINTAIN A NIGHT SETBACK TEMPERATURE OF 58 DEGREES F. (WINTER ONLY)

WHENEVER THE SUPPLY FAN IS DE-ENERGIZED, THE OUTSIDE AIR DAMPERS WILL BE CLOSED AND DX COOLING COIL WILL BE DE-ENERGIZED.

SMOKE DETECTOR AND FREEZESTAT WILL DE-ENERGIZE THE FANS WHEN THEIR SETPOINTS ARE REACHED.

LIFT VENTILATOR CONTROL

THE CONTROL PAK DDC SYSTEM WILL ISSUE COMMAND TO THE UNIT VENTILATOR CONTROLLER TO ENERGIZE OR DE-ENERGIZE THE OCCUPIED OR UNOCCUPIED MODE.

DURING THE WARM-UP CYCLE THE OUTSIDE AIR DAMPER AND RELIEF AIR DAMPER WILL BE FULLY CLOSED AND THE RETURN AIR DAMPER WILL BE FULLY OPEN.

WHEN THE WARM-UP CYCLE IS COMPLETED AND THE DESIRED SPACE TEMPERATURE IS REACHED, THE OUTSIDE AIR DAMPER WILL OPEN TO MINIMUM POSITION OR AS REQUIRED. THE HEATING COIL VALVE WILL BE MODULATED THROUGH THE UNIT VENTILATOR CONTROLLER TO MAINTAIN THE DESIRED SPACE TEMPERATURE.

WHEN THE SPACE TEMPERATURE EXCEEDS ITS SETPOINT AND THE HEATING COIL CONTROL VALVE IS FULLY CLOSED THROUGH THE UNIT VENTILATOR CONTROLLER, THE OUTSIDE AIR DAMPER WILL MODULATE FULLY OPEN TO MAINTAIN SPACE TEMPERATURE. THE DISCHARGE AIR SENSOR WILL OVERRIDE THE SPACE SENSOR THROUGH THE DDC CONTROLLER TO MAINTAIN A MINIMUM DISCHARGE AIR TEMPERATURE OF 55 DEGREES F. (ADJUSTABLE)

IF THE SPACE TEMPERATURE CONTINUES TO EXCEED ITS SETPOINT WHEN OUTSIDE AIR DAMPERS ARE FULLY OPEN AND THE OUTSIDE AIR TEMPERATURE IS ABOVE 55 F. THEN THE MECHANICAL COOLING WILL OCCUR. THE OUTSIDE AIR DAMPERS WILL CLOSE TO A MINIMUM POSITION AND THE SPACE SENSOR WILL CYCLE THE CONDENSING UNIT THROUGH THE UNIT VENTILATOR CONTROLLER TO MAINTAIN SPACE TEMPERATURE.

DURING THE UNOCCUPIED PERIOD THE UNIT VENTILATOR WILL CYCLE IN FULL RECIRCULATION MODE TO MAINTAIN NIGHT SETBACK TEMPERATURE AS DETERMINED THROUGH THE UNIT VENT DDC CONTROLLER.

INCLUDE IN BASE BID

CT₁ CONTROLLED TEMPERATURE INC.
1897 WEST DRIVE, VALLEJO, CALIF. 94590 TEL. (916) 669-0500

PROJECT:

ANCHOR BAY SCHOOL DISTRICT

DEAN NAURETT ELMENYARY
(RTUS AND UNIT VENT SEQUENCE OF OPERATION)

NEW BALTIMORE

DESIGN BY:	DATE:	SHEET 11 OF 14	JOB NO.
THLS	6-8-95		HVAC-329

MICHIGAN

LAN ADDRESS 01
SERVES MAIN OFFICE AREA



PROJECT:

DEAN A. DRETT ELEMENTARY

ROOF TOP UNIT #1 & 2 OFFICE CONTROL 1AN-01)

NEW BALTIMORE

DEATH	1000000
-------	---------


BY: _____

THIS 10-22-01

00000000000000000000000000000000

SPACE TEMP.
TEACHERS LOUNGE (AI-15)
TEACHERS WORKROOM (AI-18)

RTU-1 & 2 AHU SOFTWARE
LAN ADDRESS 01

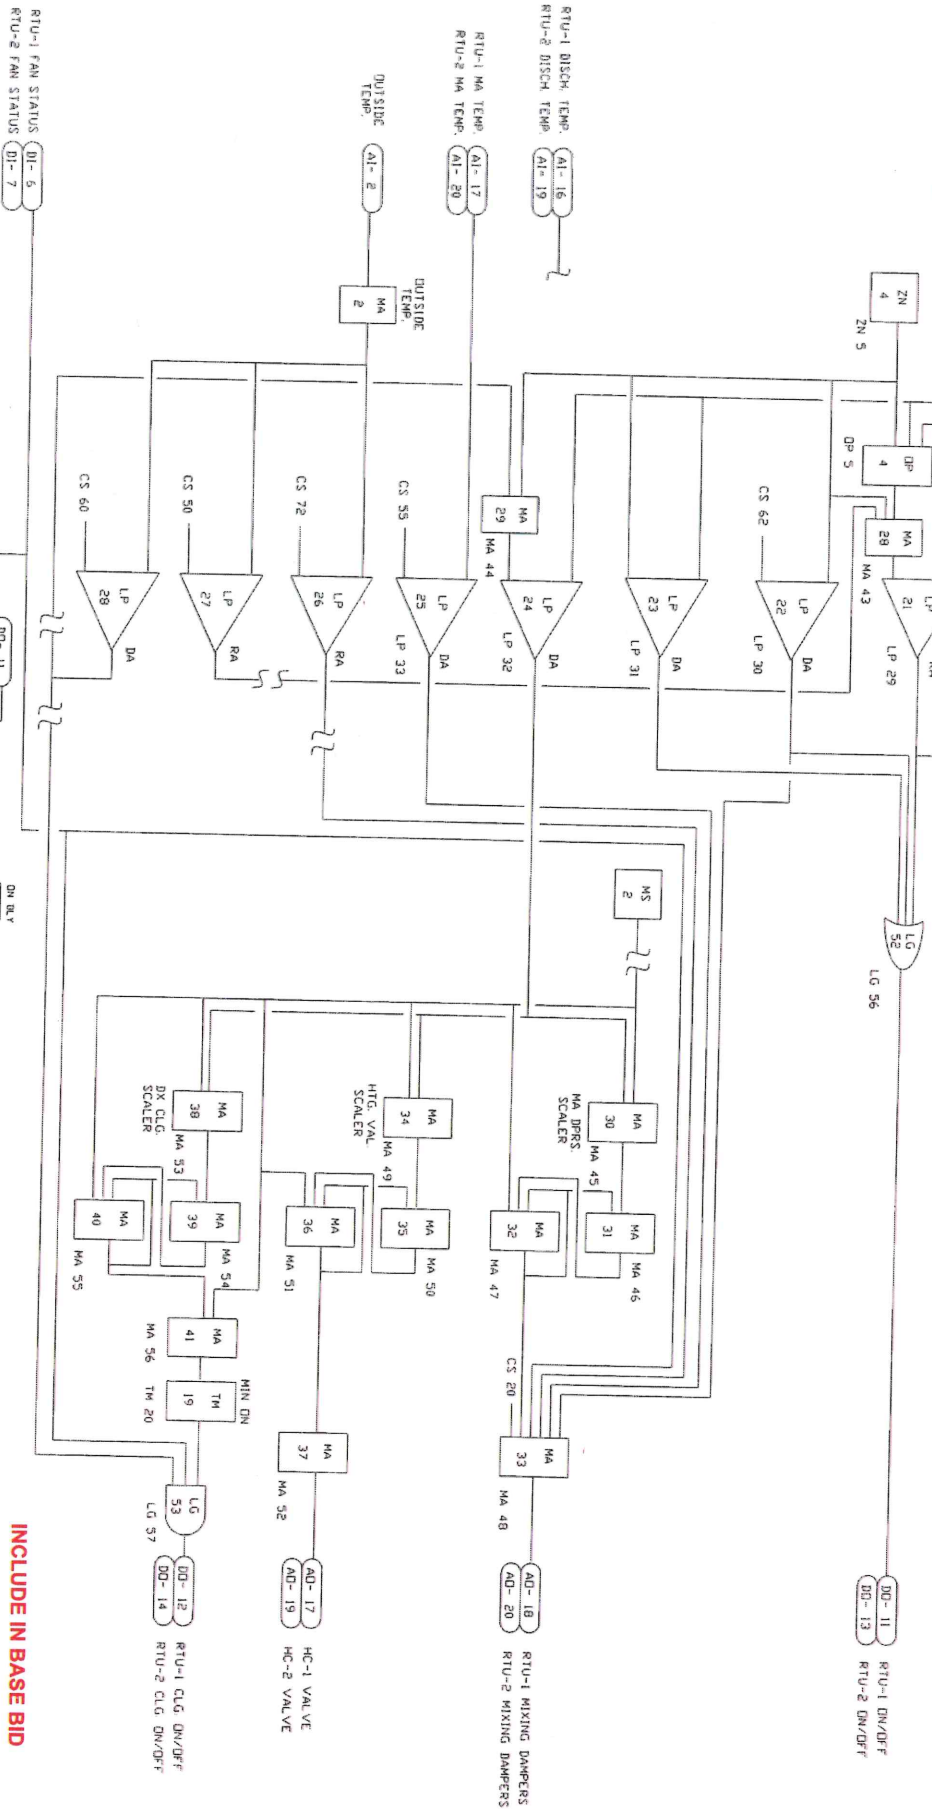

INCLUDE IN BASE BID

CT CONTROLLED TEMPERATURE INC.
1897 WEST DRIVE, VALLEY LAKE, ILL. 60090 TEL. (312) 665-0500

RTU-1 FAN STATUS (DI-5)
RTU-2 FAN STATUS (DI-7)

ANCHOR BAY SCHOOL DISTRICT
DEAN VALDETTI ELEMENTARY
(RDP TDP UNIT #1 & 2 SOFTWARE LAN-01)

PROJECT: NEW BAY THERM
DATE: 10-22-01
BY: 6-5-95
SHEET 13 OF 14
JOB NO. HVAC-329
MICHIGAN


UNIT VENTILATOR DAY/NIGHT CHANGE-OVER SOFTWARE

LAN ADDRESS 01



UNIT VENTILATOR CONTROL

ONE LINE THIS
LAN ADDRESS 01

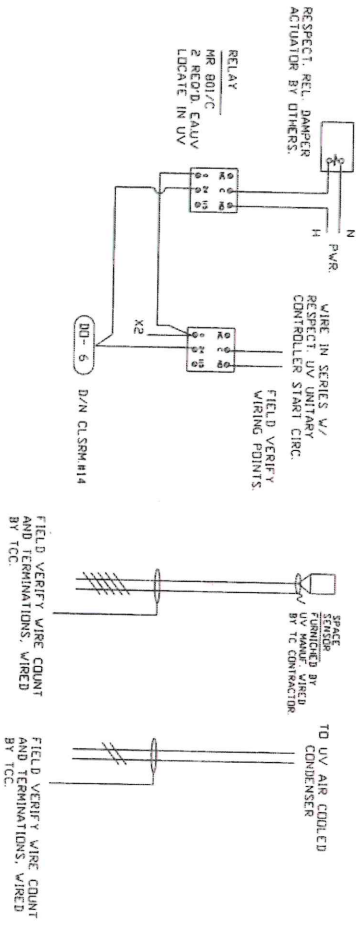

INCLUDE IN BASE BID

CT₁ CONTROLLED TEMPERATURE INC.
1897 WEST DRIVE, VALLEY LAKE, ILL. 60050 TEL. (312) 669-0500

PROJECT: ANCHOR BAY SCHOOL DISTRICT
DEAN SAIDRETT ELLIOTT
(UNIT VENT CONTROL & SOFTWARE)

DRAWN BY:	NEV BALTIMORE	CHECKED DATE:	6-8-95	SHEET 14 OF 14	JOB NO:	HVAC-329
THIS						

ARCHITECT & PLANNERS : ROY G. FRENCH ASSOCIATES, INC.
CONSULTING ENGINEERS : PETER BASSO ASSOCIATES INC.
CONSTRUCTION MANAGEMENT : BARTON MALOW COMPANY
MECHANICAL CONTRACTOR : DUAL TEMP MECHANICAL AND REFRIGERATION

LAN 02

ANCHOR BAY SCHOOL DISTRICT
DEAN WALDRETT ELEMENTARY SCHOOL

SYSTEM

TITLE PAGE

LAN ADDRESS 02

CT CONTROLLED TEMPERATURE INC.
1897 BCT DRIVE - VALLEJO LANE WICK 48390 TEL 9248 669-9560

FILE NAME:
ASBUILT BY: KOS DATE: 09-21-00

ABRIN201
JOB NO. 96-253

ANALOG INPUT BOARD #01		
A#	POINT DESCRIPTION	EQUIPMENT
01	CALIBRATION RESISTOR	RTU-1
02	DA TEMP.	TC-1
03	SPACE TEMP.	TC-2
04	SPACE TEMP.	TC-3
05	SPACE TEMP.	RTU-2
06	DA TEMP.	RTU-2
07	RA TEMP.	TC-4
08	SPACE TEMP.	TC-5
09	SPACE TEMP.	FCU
10	SPACE TEMP.	FCU
11	SPACE TEMP.	RCP
12	SPACE TEMP.	RCP
13	SPACE TEMP.	RCP
14	HWS TEMP.	HX-1
15	SPARE	
16	SPARE	

ANALOG INPUT BOARD #02		
A#	POINT DESCRIPTION	EQUIPMENT
17	M.A. TEMP.	RTU-3
18	D.A. TEMP.	RHC
19	SPACE TEMP.	RHC
20	SPACE TEMP.	RHC
21	R.A. TEMP.	RTU-3
22	SPACE TEMP.	RHC
23	SPACE TEMP.	RHC
24	SPACE TEMP.	RHC
25	RTU-1 STATUS	RTU-1
26	RTU-2 STATUS	RTU-2
27	CP-3 STATUS	CP-3
28	CP-4 STATUS	CP-4
29	RTU-3 FILTER	RTU-3
30	RTU-3 STATUS	RTU-4
31	SPARE	
32	SPARE	

DIGITAL OUTPUT BOARD #01		
DO#	POINT DESCRIPTION	EQUIPMENT
01	UV OCC/UNOCC	UNIT VENTS
02	UV OCC/UNOCC	UNIT VENTS
03	UV OCC/UNOCC	UNIT VENTS
04	UV OCC/UNOCC	UNIT VENTS
05	S. FAN ON/OFF	RTU-1
06	1ST STAGE CLG.	RTU-1
07	S. FAN ON/OFF	RTU-2
08	1ST STAGE CLG.	RTU-2
09	2ND STAGE CLG.	RTU-2
10	1ST STAGE CLG.	RTU-2
11	NOT FUNCTIONAL	RTU-3
12	EF-1&2 ON/OFF	EF'S 1&2
13	EF-3 ON/OFF	EF-3
14	EF-4 ON/OFF	EF-4
15	FCU ON/OFF	FCU
16	FCU ON/OFF	FCU

DIGITAL OUTPUT BOARD #02		
DO#	POINT DESCRIPTION	EQUIPMENT
01	UV OCC/UNOCC	UNIT VENTS
02	UV OCC/UNOCC	UNIT VENTS
03	UV OCC/UNOCC	UNIT VENTS
04	UV OCC/UNOCC	UNIT VENTS
05	S. FAN ON/OFF	RTU-1
06	1ST STAGE CLG.	RTU-1
07	S. FAN ON/OFF	RTU-2
08	1ST STAGE CLG.	RTU-2
09	2ND STAGE CLG.	RTU-2
10	1ST STAGE CLG.	RTU-2
11	NOT FUNCTIONAL	RTU-3
12	EF-1&2 ON/OFF	EF'S 1&2
13	EF-3 ON/OFF	EF-3
14	EF-4 ON/OFF	EF-4
15	FCU ON/OFF	FCU
16	FCU ON/OFF	FCU

ANCHOR BAY SCHOOL DISTRICT
DEAN VALDRETT ELEMENTARY SCHOOL

SYSTEM
POINT TERMINATIONS
LAW 2

ANALOG OUTPUT BOARD #01		
AO#	POINT DESCRIPTION	EQUIPMENT
01	HW VALVE	RTU-1
02	HW VALVE	TC-1
03	HW VALVE	TC-2
04	HW VALVE	TC-3
05	HW VALVE	TC-4
06	HW VALVE	TC-5
07	SPARE	
08	HW VALVE	RCP
09	HW VALVE	RCP
10	HW VALVE	RCP
11	HW VALVE	RCP
12	SPARE	HX-1
13	SPARE	
14	SPARE	
15	SPARE	
16	SPARE	

ANALOG OUTPUT BOARD #02		
AO#	POINT DESCRIPTION	EQUIPMENT
17	SPARE	
18	SPARE	
19	SPARE	
20	SPARE	
21	SPARE	
22	MA DAMPER	RTU-3
23	HW VALVE	RHC
24	HW VALVE	RHC
25	HW VALVE	RHC
26	HW VALVE	RHC
27	HW VALVE	RHC
28	HW VALVE	RHC
29	SPARE	
30	SPARE	
31	SPARE	
32	SPARE	

DIGITAL OUTPUT BOARD #01		
DO#	POINT DESCRIPTION	EQUIPMENT
17	FCU ON/OFF	FCU
18	FCU ON/OFF	FCU
19	PUMP ON/OFF	CP-3
20	PUMP ON/OFF	CP-4
21		
22	EF ON/OFF	EF
23	S.FAN ON/OFF	RTU-3
24	SPARE	
25	SPARE	
26	SPARE	
27	SPARE	
28	SPARE	
29	SPARE	
30	SPARE	
31	SPARE	
32	SPARE	

DIGITAL OUTPUT BOARD #02		
DO#	POINT DESCRIPTION	EQUIPMENT
17	FCU ON/OFF	FCU
18	FCU ON/OFF	FCU
19	PUMP ON/OFF	CP-3
20	PUMP ON/OFF	CP-4
21		
22	EF ON/OFF	EF
23	S.FAN ON/OFF	RTU-3
24	SPARE	
25	SPARE	
26	SPARE	
27	SPARE	
28	SPARE	
29	SPARE	
30	SPARE	
31	SPARE	
32	SPARE	

CTI CONTROLLED TEMPERATURE INC.

FILE NAME: ABD00202
ASBULT BY: KOS DATE: 10-22-00 JOB NO: 98-253

CT CONTROLLED TEMPERATURE INC.

FILE NAME: ABDN0203A RTU-1 VIPINC

ASBUILT BY: KDS DATE: 10-22-01 JOB NO 00-138



ANCHOR BAY SCHOOL DISTRICT DEAN MALDRETT ELEMENTARY SCHOOL


SYSTEM

ROOF TOP UNIT # 2 CONTROL DIAGRAM

LAN ADDRESS: 02
SERVES THE MEDIA CENTER

CT CONTROLLED TEMPERATURE INC.

1897 BEST DRIVE, VALDE LAK MICH 49789 TEL (248) 669-0580
FILE NAME: ABBINGDIA RTU-2 CONTROL DIAGRAM
ASBUILT BY: KOS DATE: 10-22-01 JOB NO. 90-253

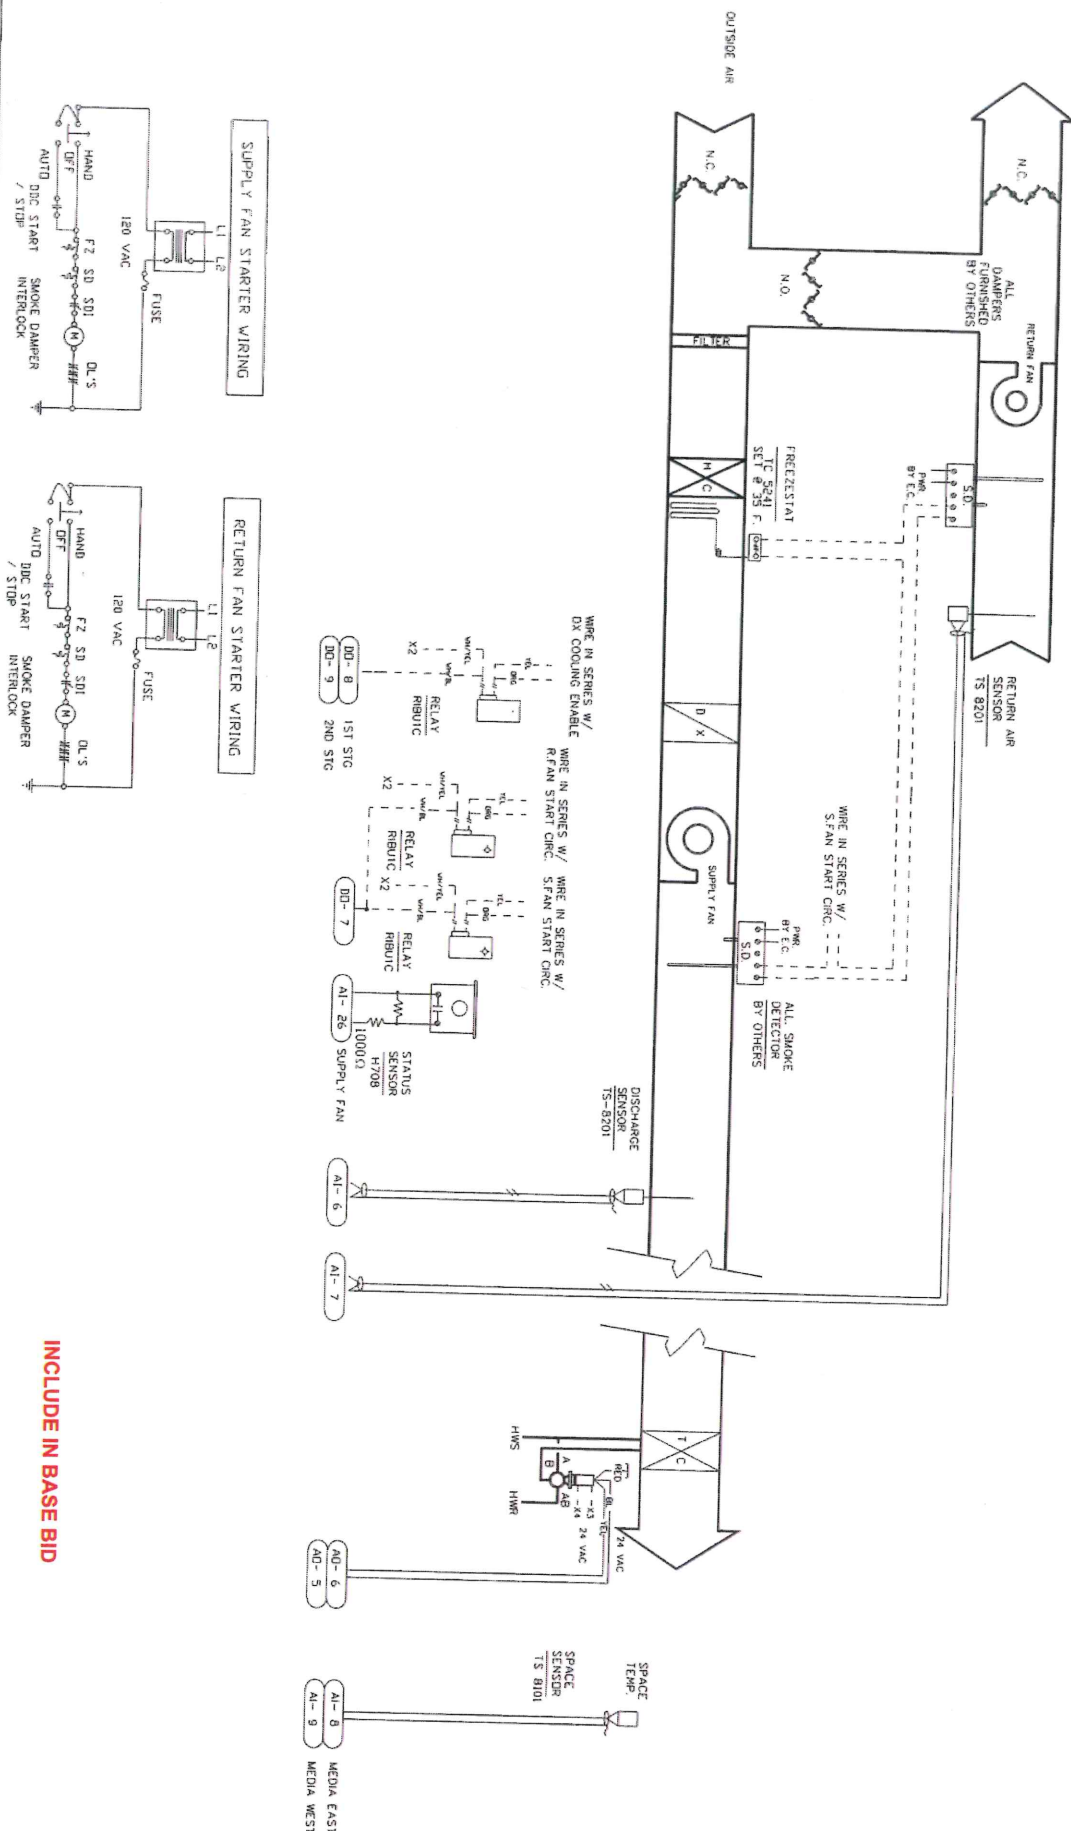

INCLUDE IN BASE BID

ANCHOR BAY SCHOOL DISTRICT
DEAN NALDRETT ELEMENTARY SCHOOL

SYSTEM

VERTICAL UNIT VENTILATOR CONTROL DIAGRAM.

LAN 02

CT CONTROLLED TEMPERATURE INC.


FILE NAME: ABRN0206 U/V SOFTWARE

ASBUILT BY: LMF DATE: 6-13-00 JOB NO. 98-233

TC	1
SCHEDULE 1	ON
06:00	SUN 2
22:00	MON 1
OFF	TUE 1
SCHEDULE 2	OFF
00:01	WED 1
OFF	THU 1
OFF	FRI 1
OFF	SAT 1
OFF	SUN 2
HOL	2

UNIT VENTILATOR DAY/NIGHT CHANGE-OVER SOFTWARE

LAN ADDRESS 02

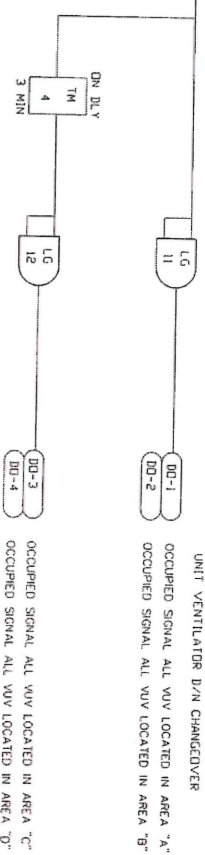


UNIT VENTILATOR D/N CHANGEOVER

OCCUPIED SIGNAL ALL VUV LOCATED IN AREA "A"

OCCUPIED SIGNAL ALL VUV LOCATED IN AREA "C"

INCLUDE IN BASE BID

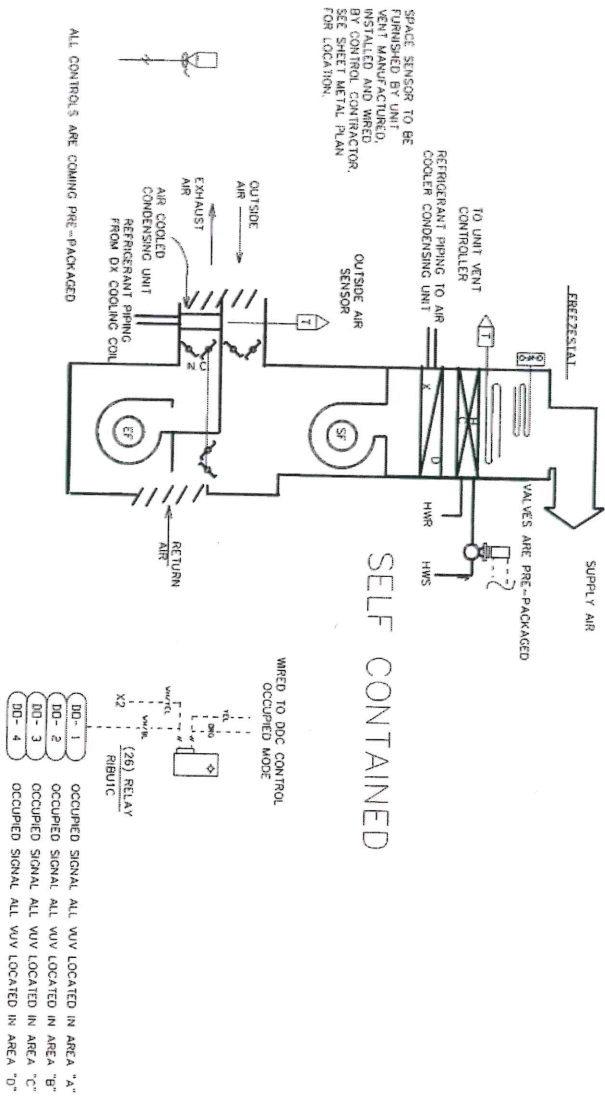

SELF CONTAINED

SEQUENCE OF OPERATION

TYPICAL VERTICAL UNIT VENTILATOR CONTROL

1. THE DDC SYSTEM WILL ISSUE A COMMAND TO THE UNIT VENTILATOR CONTROLLER TO ENERGIZE OR DE-ENERGIZE THE OCCUPIED OR UNOCCUPIED MODE
2. PRE-PACKAGED SELF CONTAINED UNIT

TYPICAL VERTICAL UNIT VENTILATOR CONTROL

[illegible]

TYPICAL HORIZONTAL FAN COIL CONTROL "SELF CONTAINED CONTROLS"

2. DURING THE UNOCCUPIED PERIOD THE FAN COIL UNITS WILL CYCLE IN FULL REGENERATION MODE TO MAINTAIN MIST SET BACK TEMPERATURES AS DEFINED THROUGH THE UNIT VERT DDC CONTROLLER AND THE RELIEF DAMPER SHALL BE FULLY CLOSED.



SYSTEM


TYPICAL HORIZONTAL FAN COIL CONTROL

5 LIKE THIS. LOCATED IN AREAS 'A','B','C'.

CT CONTROLLED TEMPERATURE INC.

FILE NAME:	ABJN0207	CHANGE OVER	SOFTWARE
ASSEMBLY BY:	KDS	DATE:	10-22-01
		JOB NO.	98-253

REMOTE OUTSIDE AIR DAMPER AND
DAMPER ACTUATOR FURNISHED BY
UNIT MANUFACTURER. ALL
WIRING AND WIRING TERMINATIONS
BY TEMPERATURE CONTROL CONTRACTOR

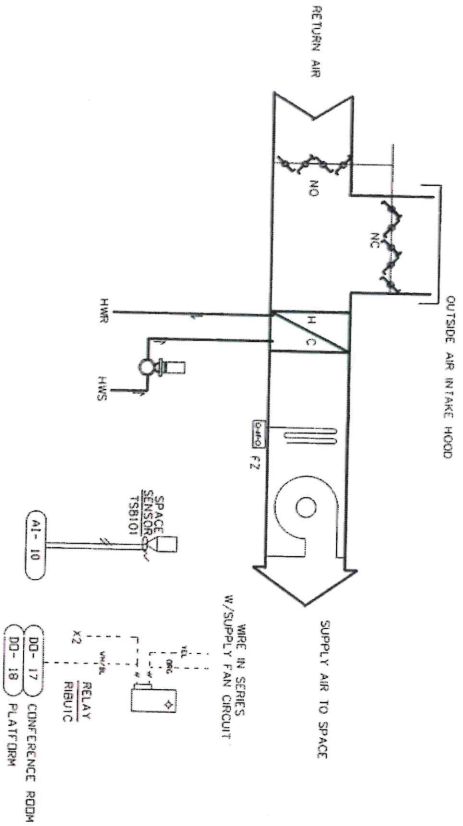

SEQUENCE OF OPERATION

TYPICAL HORIZONTAL FAN COIL CONTROL "SELF CONTAINED CONTROLS"

1. THE DDC SYSTEM WILL ISSUE COMMAND TO THE COIL UNIT CONTROLLER TO ENERGIZE OR DE-ENERGIZE THE UNOCCUPIED OR OCCUPIED MODE. DURING THE UNOCCUPIED MODE THE UNIT VENTILATION SHALL BE STARTED AND SHALL RUN CONTINUOUSLY.
2. DURING THE UNOCCUPIED PERIOD THE FAN COIL UNITS WILL CYCLE IN FULL RECIRCULATION MODE TO MAINTAIN NIGHT SET BACK TEMPERATURE AS DETERMINED BY THE DDC SYSTEM. THE UNIT VENT DAMPER AND THE RELIEF DAMPER SHALL BE FULLY CLOSED.

INCLUDE IN BASE BID

ANCHOR BAY SCHOOL DISTRICT
DEAN NALDRETT ELEMENTARY SCHOOL

SYSTEM

TYPICAL HORIZONTAL FAN COIL CONTROL

LAN ADDRESS: 02

SERVES CONF. ROOM & PLATFORM

CT CONTROLLED TEMPERATURE INC.

1897 BEST DRIVE, VALLEJO LAKE HIGH 48290 TEL. (249) 669-0500

FILE NAME: ADD00207B


ASBUILT BY: TAN DATE: 10-22-01 JOB NO. 98-223

CT CONTROLLED TEMPERATURE INC.

1897 BEST DRIVE, VALLED LAKE MICH 48390 TEL. (248) 669-0500


FILE NAME: ABD0208 RADIANT PANEL SOFTWARE

ASBUILT BY: LMF? DATE: 6-13-00 JOB NO. 98-253

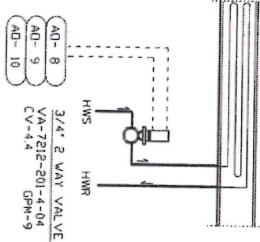


SEQUENCE OF OPERATION

THE RADIANT CEILING PANEL CONTROL VALVE AND HEATING COIL CONTROL VALVE SHALL BE MODULATED THROUGH THE UNIT VENTILATOR CONTROLLER.

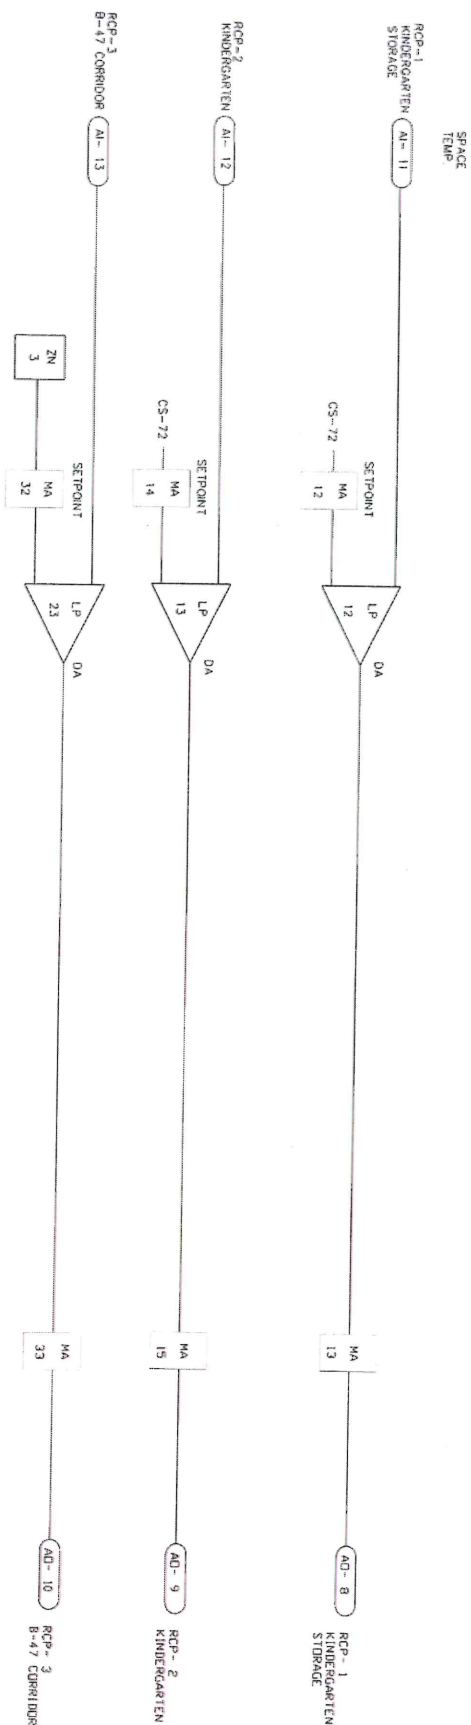


INCLUDE IN BASE BID

EXHAUST FAN CONTROL DIAGRAM

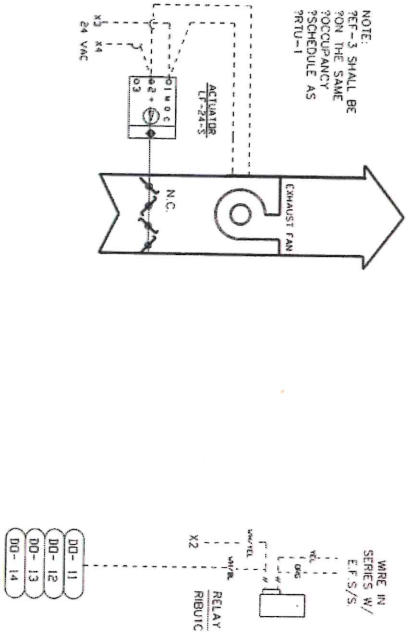

EXHAUST FAN CONTROL LOGIC

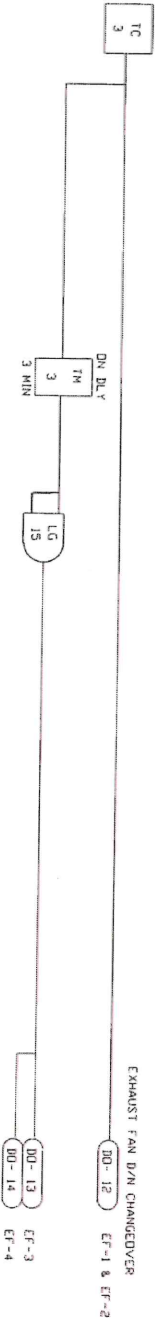


INCLUDE IN BASE BID

ANCHOR BAY SCHOOL DISTRICT
DEAN NALDRETT ELEMENTARY SCHOOL

SYSTEM
EXHAUST FAN CONTROL DIAGRAM
LAN 02

CT CONTROLLED TEMPERATURE INC.
1897 WEST DRIVE, VALLEJO, CA 94590 TEL: (415) 669-0500

FILE NAME: ABBV0209 EXHAUST FAN
ASBUILT BY: LMF? DATE: 6-13-00 JOB NO: 98-253

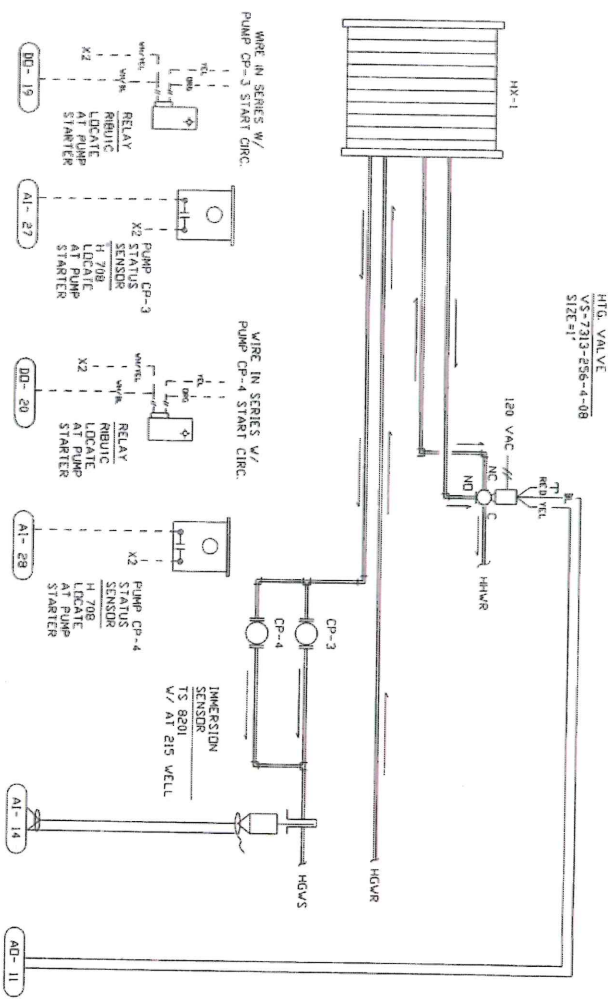


HWS VALVE
VS-7313-256-4-08
SIZE 1"

SEQUENCE OF OPERATION

1. THE HOT GLYCOL HEATING CIRCULATING PUMPS CP-3 AND CP-4 MOTOR STARTER HAND/OFF/AUTO SWITCHES ARE TO BE PLACED IN THE "AUTO" POSITION.
2. ONE CIRCULATING PUMP (CP-3 OR CP-4) WILL BE DESIGNATED AS THE "LEAD" PUMP AND THE OTHER PUMP WILL BE DESIGNATED AS THE "STANDBY" PUMP THROUGH OPERATOR INTERFACE TO THE DDC SYSTEM. THE "LEAD" PUMP WILL BE ENERGIZED THROUGH THE DDC SYSTEM AND WILL RUN CONTINUOUSLY WHENEVER ANY OF THE BOILER PRIMARY PUMPS ARE ENERGIZED.
3. THE HOT GLYCOL HEATING CIRCULATING PUMPS ON/OFF STATUS WILL BE PROVEN TO THE DDC SYSTEM BY MEANS OF THE PUMP MOTOR CURRENT SWITCH. IF THE "LEAD" PUMP HAS FAILED AS SENSED BY THE PUMP MOTOR CURRENT SWITCH, THE DDC SYSTEM WILL AUTOMATICALLY ENERGIZE THE "STANDBY" PUMP AND INDICATE A PUMP FAILURE ALARM. ONLY ONE PUMP WILL RUN AT ANY TIME. THE LEAD PUMP AND STANDBY PUMP WILL BE ALTERNATED EVERY 1000 HOURS THROUGH THE DDC SYSTEM.
4. THE HOT GLYCOL HEATING SUPPLY (HWS) TEMPERATURE SENSOR, THROUGH DDC, WILL MODULATE THE 3-WAY MIXING CONTROL VALVE TO MAINTAIN HOT GLYCOL HEATING SUPPLY TEMPERATURE SETPOINT. THE HOT WATER HEATING SUPPLY TEMPERATURE WILL BE RESET BASED ON THE OUTSIDE AIR TEMPERATURE RESET SCHEDULE.

TYPICAL HIGH PUMP STARTER WIRING

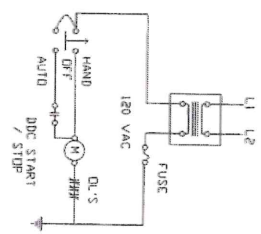

ANCHOR BAY SCHOOL DISTRICT
DEAN NALDRITT ELEMENTARY SCHOOL

SYSTEM
HEAT EXCHANGER CONTROL WIRING


LAN 2

CT CONTROLLED TEMPERATURE INC.

FILE NAME: ABB00210 HEAT EXCHANGER SD-TWAVE
ASBULT BY: TUN DATE: 6-13-00 JOB NO: 98-253

INCLUDE IN BASE BID

HEAT EXCHANGER CONTROL SOFTWARE

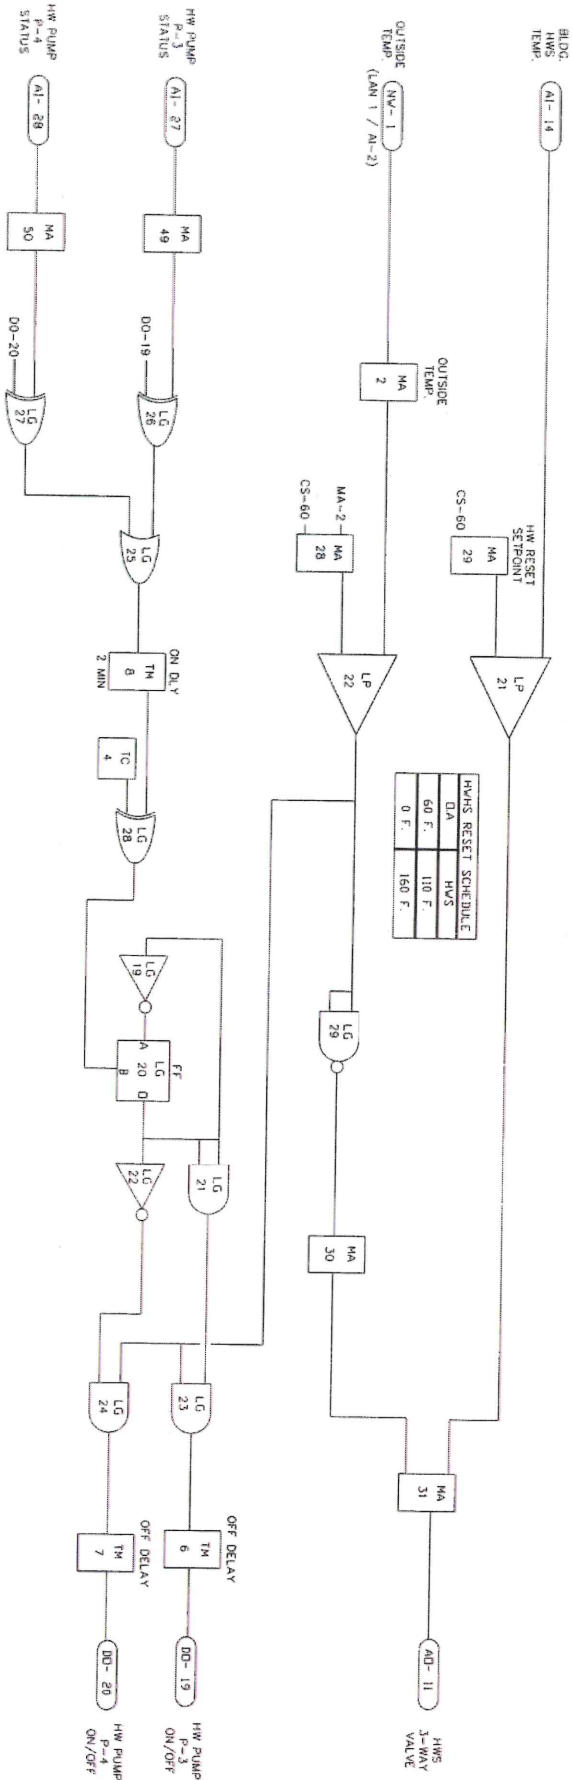

INCLUDE IN BASE BID

ANCHOR BAY SCHOOL DISTRICT
DEAN NALDRETT ELEMENTARY SCHOOL

SYSTEM
HEAT EXCHANGER CONTROL SOFTWARE

LAN 2

CT CONTROLLED TEMPERATURE INC.
1897 WEST DRIVE, WALED LAKE MICH 48390 TEL (248) 669-6580

FILE NAME: ABINORDIO HEAT EXCHANGER SOFTWARE
ASBUILT BY: TAN DATE: 6-13-00 JOB NO. 98-253

ADDRESS: 47600 SUBARUSHI, NEW BALTIMORE, MI 4804

LAN ADDRESS 02

CT CONTROLLED TEMPERATURE INC.
1897 BEST DRIVE, VALLEJO LAKE HIGH 40390 TEL. (214) 663-0551

FILE NAME: RTU-3.dwg
DRAWN BY: KDS DATE: 10-22-01 JOB NO. 00-139

06A




HM VALUE SCHEDULE							
UNIT	PAAT NO.	CONFG.	SIZE	CV	GPM	WPD(V)	WPD(C)
HC-7	V57211-201-4-02	2-WAY	1/2"	1.3	1.8	1.38"	1.6'
HC-8	V57211-201-4-02	2-WAY	1/2"	1.3	2.8	4.6"	0.9'
HC-9	V57211-201-4-02	2-WAY	1/2"	1.3	0.6	21"	0.2'

NOTE: CONTROL VALVE PRESSURE DROP WILL EQUAL 2.5 TIMES THE ASSOCIATED COIL WATER PRESSURE DROP.
(MIN. 2.3' MAX. 15')

RADIANT CEILING PANEL, HW VALVE SCHEDULE							
UNIT	PART NO.	CONFIG.	SIZE	CV	GPM	WBD(V)	WPD(C)
ROP-1	VS-7211-201-4-01	2-WAY	1/2"	0.4	1.0	6.25"	3.8"


NOTE: CONTROL VALVE PRESSURE DROP WILL EQUAL 2.5 TIMES THE ASSOCIATED COIL WATER PRESSURE DROP.
(MIN. 2.3' MAX. 15')

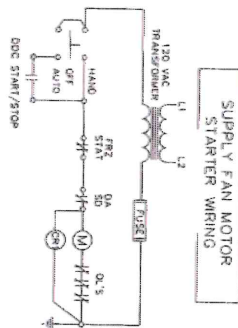

INCLUDE IN BASE BID

ROOFTOP UNIT 3 CONTROL SOFTWARE DIAGRAM

LAN ADDRESS 02

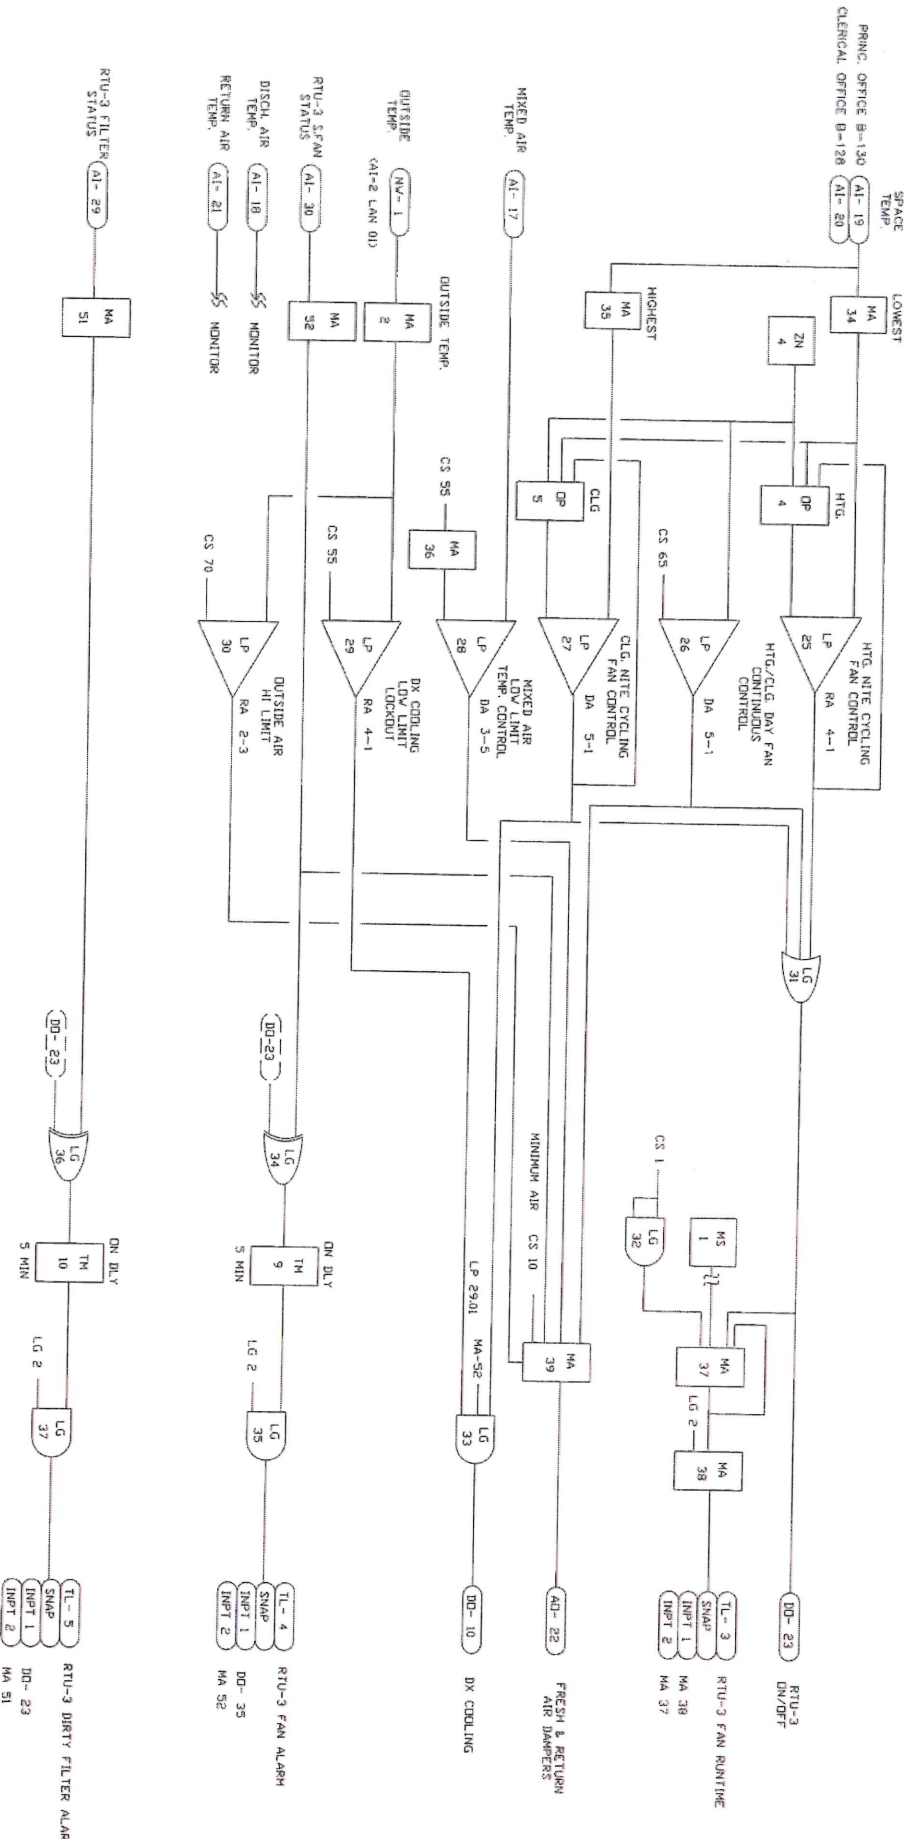

INCLUDE IN BASE BID

ANCHOR BAY SCHOOL DISTRICT
VALDETT ELEMENTARY SCHOOL

SYSTEM
ROOFTOP UNIT 3 CONTROL SOFTWARE DIAGRAM

CT CONTROLLED TEMPERATURE INC.
1897 BEST DRIVE, VALDETT LAKE HIGH 4890 TEL: (248) 669-0500

06B



PAGE NUMBER