




Centrix Energy
792 Lois Dr.
Sun Prairie, WI 53590

[illegible]TRANSPORTATION
BUILDINGMECHANICAL
COVER SHEET

Project Number: _____

Date: 4/06/2021

M000

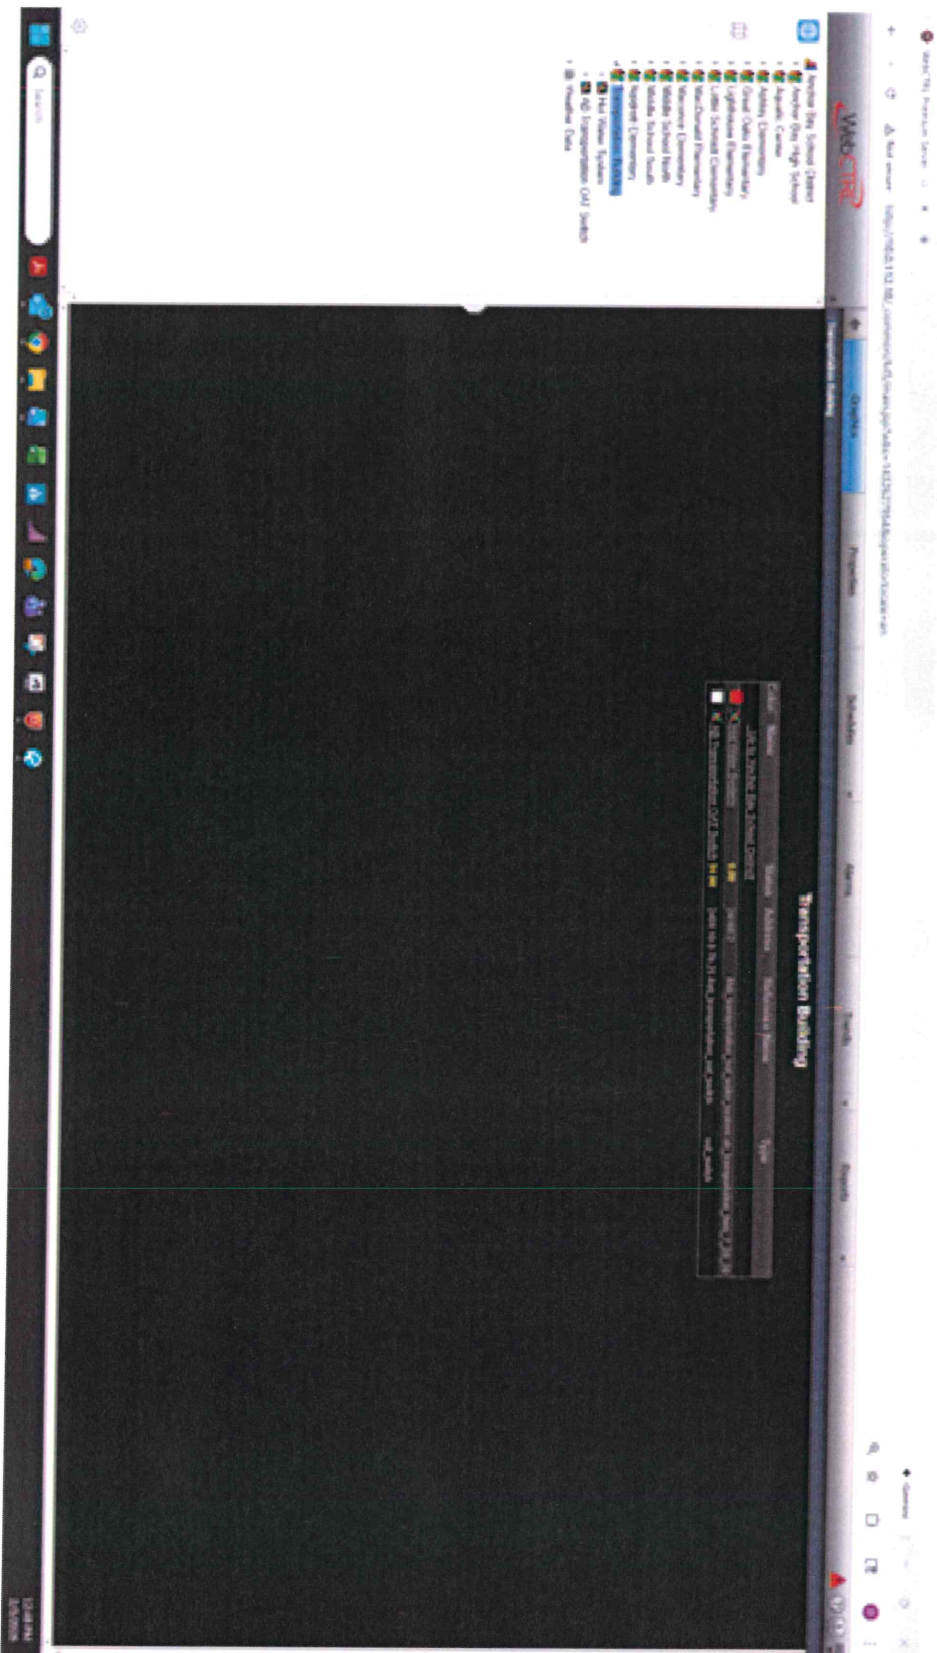

EXISTING DDC - ALC



Centrix Energy
 1000 W. Main St.
 Madison, WI 53703
 (608) 255-8000

No.	Description	0

ANCHOR BAY
 SCHOOL DISTRICT
 DDC CONTROLS
 UPGRADES

TRANSPORTATION
 BUILDING

REQUEST FOR PROPOSAL

EXISTING
 DDC - ALC

REQUEST FOR PROPOSAL

Project Number:

Date: 4/08/

M001

Transportation Building

Item #	Area Served	Legacy Controls Page Number	Notes
BC-1	Office Area	4 of 9	Include (8) zones w/ RH coils
BC-2	Mezzanine	5 of 9	
ERU	Service Bays (garage area)	6 of 9	
VEF-1	Service Bays (garage area)	8 of 9	
IFH	Service Bays (garage area)	8 of 9	
EF-2	Wash Bay	6 of 9	
EF-3	Electrical Room	7 of 9	
CUH	Vestibule	8 of 9	

No.	Description
1	
2	
3	
4	
5	
6	
7	
8	
9	
10	


ANCHOR BAY
SCHOOL DISTRICT
DDC CONTROLS
UPGRADES

TRANSPORTATION
BUILDING

REQUEST FOR PROPOSAL
EQUIPMENT
SCHEDULE FOR
DDC UPGRADE

REQUEST FOR PROPOSAL
Project Number:
Date: 4/06/2

M002

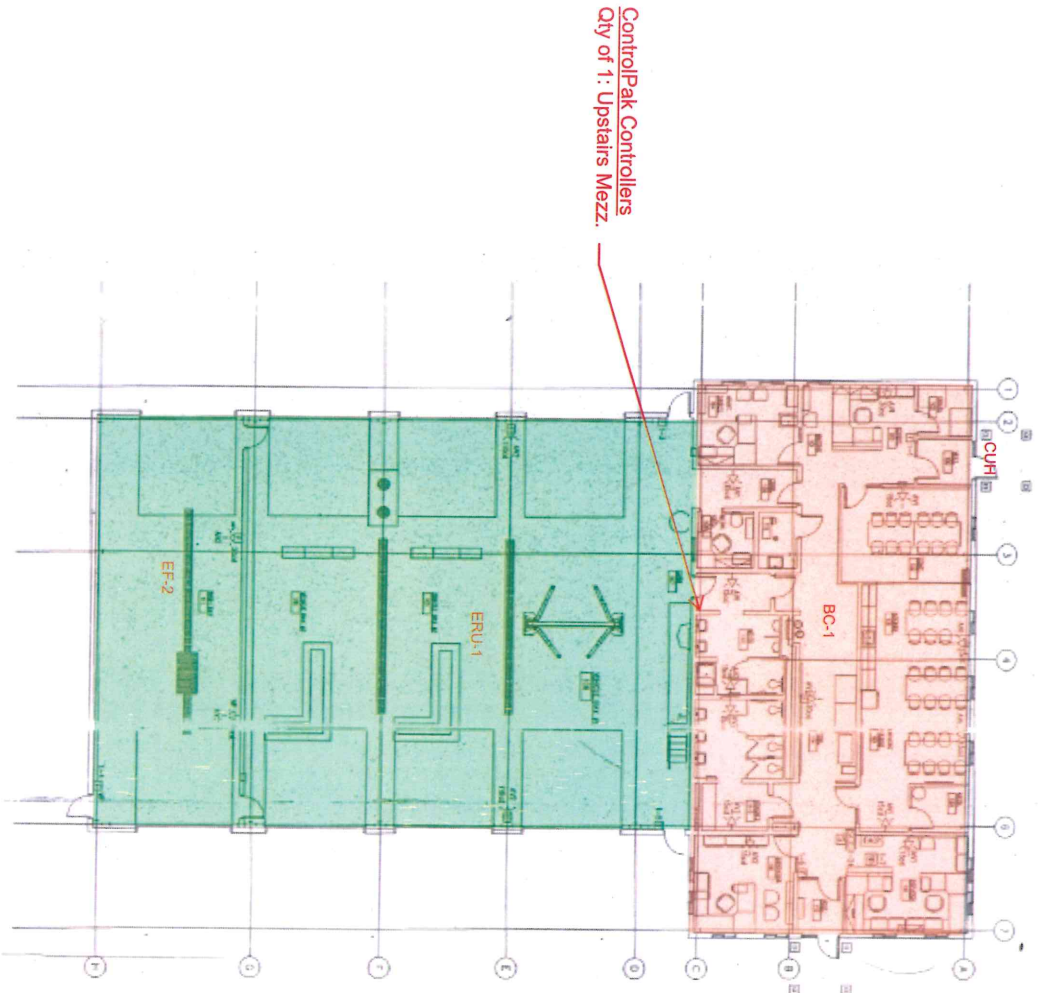

FLOORPLAN FOR DDC UPGRADE

No.	Description
1	
2	
3	
4	
5	
6	
7	
8	
9	
10	

ANCHOR BAY
SCHOOL DISTRICT
DDC CONTROLS
UPGRADES

TRANSPORTATION
BUILDING

REQUEST FOR PROPOSAL
FLOORPLAN
FOR DDC
UPGRADE

REQUEST FOR PROPOSAL
Project Number:
Date:

M003


4/06/22

TEMPERATURE CONTROLS FOR ANCHOR BAY SCHOOL DISTRICT TRANSPORTATION CENTER

ARCHITECTS, PLANNERS, INTERIORS: French Associates
CONSTRUCTION MANAGEMENT: Barton Malow
MECHANICAL CONTRACTOR: Macomb Mechanical Inc.

TEMPERATURE CONTROLS CONTRACTOR: Controlled Temperature, Inc.

SYSTEM ARCHITECTURE

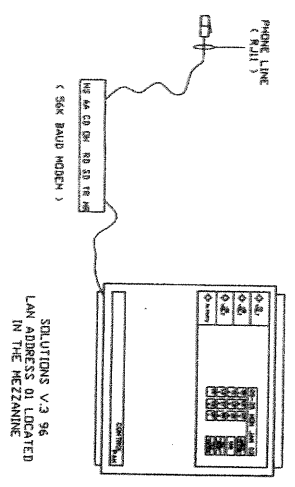

DRAWING	DESCRIPTION
01	TITLE PAGE WITH DRAWING INDEX
02	POINT TERMINATIONS
03A	BOILERS CONTROL WIRING
03B	BOILERS CONTROL LOGIC
04A	BLOWER COIL UNIT 1 W/REHEAT CONTROL WIRING
04B	BLOWER COIL UNIT 1 CONTROL LOGIC
04A	BLOWER COIL UNIT 1 REHEAT CONTROL LOGIC
05A	BLOWER COIL UNIT 2 CONTROL WIRING
05B	BLOWER COIL UNIT 2 CONTROL LOGIC
06A	ENERGY RECOVERY UNIT CONTROL WIRING
06B	ENERGY RECOVERY UNIT CONTROL LOGIC
07	ELECTRIC ROOM VENTILATION CONTROL WIRING
08	CUH & INFRA-RED HEATER CONTROL WIRING
09	STANDARD TERMINATIONS VALVE SCHEDULE

Anchor Bay School District
Transportation Center

51890 Washington, New Baltimore, MI 48047

SYSTEM
TITLE PAGE WITH INDEX

CT CONTROLLED TEMPERATURE INC.
1897 WEST DRIVE, VALLEY LAKE MICH. 48390 TEL. (248) 669-0500

FILE NAME: C:\JOB\ANCHOR BAY SCHOOL\TRANSPORTATION CENTER\TITLE.dwg
DRAWN BY: KDS DATE: 07/03/03 JOB NO: 02304 ASBUIL: 07/24/03

1999

[Faint, illegible handwritten text]

PROPERTY OF THE NATIONAL ARCHIVES

1990


ANK SCHEDULE

LIST OF MATERIALS

ITEM NO.	DESCRIPTION	QUANTITY	UNIT
1	1/2" DIA. STEEL PIPE	100	FEET
2	1/2" DIA. STEEL PIPE	100	FEET
3	1/2" DIA. STEEL PIPE	100	FEET
4	1/2" DIA. STEEL PIPE	100	FEET
5	1/2" DIA. STEEL PIPE	100	FEET
6	1/2" DIA. STEEL PIPE	100	FEET
7	1/2" DIA. STEEL PIPE	100	FEET
8	1/2" DIA. STEEL PIPE	100	FEET
9	1/2" DIA. STEEL PIPE	100	FEET
10	1/2" DIA. STEEL PIPE	100	FEET

- NOTES:
1. THE HOT WATER HEATING SYSTEM SHALL BE DESIGNED TO MEET THE REQUIREMENTS OF THE CITY OF CHICAGO.
 2. THE HOT WATER HEATING SYSTEM SHALL BE DESIGNED TO MEET THE REQUIREMENTS OF THE CITY OF CHICAGO.
 3. THE HOT WATER HEATING SYSTEM SHALL BE DESIGNED TO MEET THE REQUIREMENTS OF THE CITY OF CHICAGO.
 4. THE HOT WATER HEATING SYSTEM SHALL BE DESIGNED TO MEET THE REQUIREMENTS OF THE CITY OF CHICAGO.
 5. THE HOT WATER HEATING SYSTEM SHALL BE DESIGNED TO MEET THE REQUIREMENTS OF THE CITY OF CHICAGO.

NOT INCLUDED -
ALREADY CONTROLLED
BY THE ALC DDC
SYSTEM

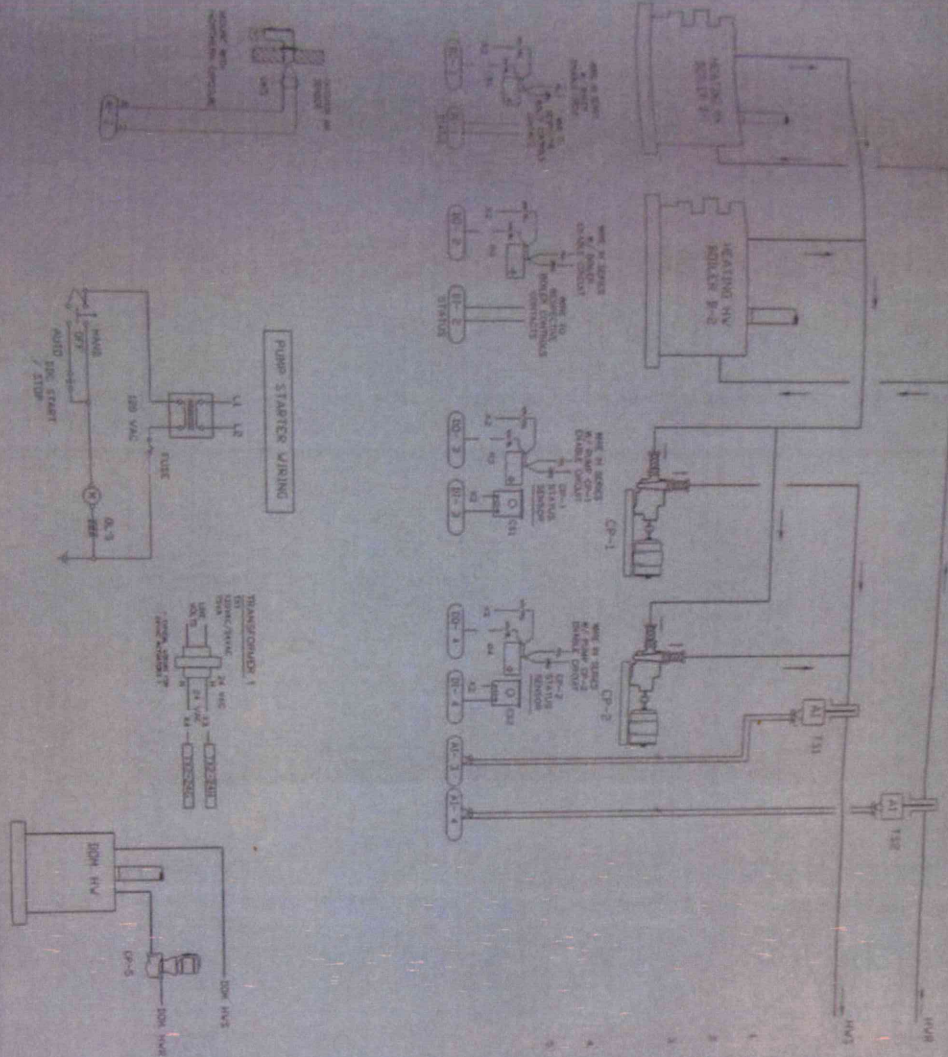

Boiler Control Wiring Diagram

SYSTEM BOILERS CONTROL WIRING DIAGRAM

CONTROLLED TEMPERATURE INC

03

NOTES: 1. THE HOT WATER HEATING SYSTEM SHALL BE DESIGNED TO MEET THE REQUIREMENTS OF THE CITY OF CHICAGO.



03B

PAGE NUMBER

MANUF.
VERIS
BELIND
BELIND
NVENSYS
VERIS
NVENSYS
NVENSYS
JCI
NVENSYS
NVENSYS
NVENSYS

4

NUMBER

51090. Washington, New Baltimore, MI 48047

LAN ADDRESS 01
SERVES THE OFFICES

FILE NAME	IDRS\ANCHOR
RAY SCHUMI C T D A L O N G V A E P U I	06-18-07 19:23

DATE: 07/02/03

JOB NO:02.304 ASBULL T.O:

PAGE 11



ITEM	QTY	PART NUMBER	DESCRIPTION	VA	MAINT
CS1-2	2	W-709	HAWKEYE CENSUS SENSING SWITCH	VA	MAINT
BM-2	2	W-58	PROP. DIRECT COUPLED DAMPER ACTUATOR	14.7	VERIS
BM-3	1	AF-52	PROP. DIRECT COUPLED DAMPER ACTUATOR	14.7	VERIS
LL1	1	W-5241	LUB. THERMO. THERMIST H/R	1.7	VERIS
RI-4	4	V100	SPRINT REC. IN A BOX	0.8	VERIS
SHK-1	1				
TS1	8	TS801	SPACE TEMPERATURE SENSORS	--	INVENTS
TS2	1	TS-8201	DUCT TEMPERATURE SENSORS	--	INVENTS
V1	1	AI150R-102	120/24VAC TRANSFORMER 150W 1%CR	50	JCI
V2	1	VS7313-201-1-42	24VAC-24VDC PROP-3-VARY MIXING VALVE	18	INVENTS
V-2-9	8	VS7313-201-1-42	24VAC-24VDC PROP-3-VARY MIXING VALVE	18	INVENTS

BILL OF MATERIALS

SEQUENCE OF OPERATION

1. AUTOMATICALLY STARTS BLOW-OUT/AIRIN SYSTEM IN THE "AUTO" POSITION, THE BLOWER COIL UNIT WILL BE DISCHARGED AND THE BLOW-OUT/AIRIN SYSTEM WILL BE RECHARGED. THE BLOW-OUT/AIRIN SYSTEM IS SCHEDULED AS PROGRAMMED THROUGH THE DDC SYSTEM.
2. WITH THE EXHAUST FAN MOTOR STARTER HAND-OFF/AUTO SWITCH IN THE "AUTO" POSITION, THE TOILET EXHAUST FAN IS STARTED DURING OCCUPIED HOURS. WHEN THE EXHAUST FAN IS STOPPED, ITS ASSOCIATED ISOLATION DAMPER WILL CLOSE. THE TOILET EXHAUST FAN WILL BE RECHARGED DURING UNOCCUPIED HOURS.
3. MAINTAIN SPACE TEMPERATURE ABOVE 59°F. (41°C) BY CLOSING "ON" AND "OFF" BY THE NIGHT CYCLE PROGRAM TO OPERATING TEMPERATURE. WHEN THE SUPPLY FAN IS STARTED PRIOR TO THE OCCUPANCY OF THE ZONE, THE UNIT WILL REMAIN CLOSED AND THE RETURN AIR DAMPER AND RELIEF AIR DAMPERS WILL OPEN.
4. WHEN THE SUPPLY FAN IS STOPPED IN THE OCCUPIED MODE, THE RETURN AIR DAMPERS WILL OPEN TO A QUANTITY.
5. THE SUPPLY FAN MOTOR CURRENT SWITCH, IF THE BLOWER COIL UNIT HAS FAILED, WILL BE SET TO THE BLOWER COIL UNIT FAILURE SWITCH. THEN AN ALARM WILL BE SENT TO THE DDC SWITCH INDICATING A BLOWER COIL UNIT FAILURE.
6. THE DISCHARGE AIR TEMPERATURE SENSOR THROUGH DDC WILL MODULATE THE MIXED AIR DAMPERS AND WHEN THE MIXED AIR DAMPERS ARE AT THEIR MINIMUM SETPOINT AND THERE IS A DISCHARGE AIR SETPOINT, SETPOINT WILL BE MAINTAINED. THE HEATING VALVE WILL BE MODULATED TO MAINTAIN THE DISCHARGE AIR SETPOINT. WHEN DISCHARGED, THE HEATING VALVE WILL BE MODULATED TO MAINTAIN THE DISCHARGE AIR DAMPERS WILL CLOSE TO MINIMUM POSITION. WHEN DISCHARGE AIR SPACE TEMPERATURE, THE MIXED AIR DISCHARGE AIR SETPOINT WILL BE CLOSING WILL BE Cycled TO MAINTAIN DISCHARGE SETPOINT. THE BLOWER COIL UNIT FAILURE SWITCH, IF THE BLOWER COIL UNIT HAS FAILED, WILL BE SET TO THE BLOWER COIL UNIT FAILURE SWITCH. THEN AN ALARM WILL BE SENT TO THE DDC SWITCH INDICATING A BLOWER COIL UNIT FAILURE.
7. THE ZONE SPACE TEMPERATURE SENSORS, THROUGH DDC, WILL MODULATE THEIR RESPECTIVE TEMPERING COIL VALVES TO MAINTAIN SPACE TEMPERATURE SETPOINT.
8. THE HOT WATER HEATING (HWH) COIL, CIRCULATING PUMP MOTOR STARTER HAND-OFF/AUTO SWITCH WILL BE RECHARGED TO THE "AUTO" POSITION. WHEN THE OUTSIDE AIR TEMPERATURE IS 55°F, (DR. BLOW-OUT/AIRIN SYSTEM) WHEN THE OUTSIDE AIR TEMPERATURE IS 60°F, (DR. BLOW-OUT/AIRIN SYSTEM) THE RECHARGING COIL, CIRCULATING PUMP WILL BE OFF.
9. PRIORITY OF FLOW STATUS FOR HWH COIL, CIRCULATING PUMP WILL BE PROVIDED TO THE DDC SYSTEM BY THE DDC SYSTEM. THE DDC SWITCH BY THE MOTOR CURRENT SWITCH, THEN AN ALARM WILL BE INDICATED TO THE DDC SYSTEM.
10. TO NORMAL POSITION AND HEATING HOT WATER VALVE, MODULATES OPEN TO MAINTAIN PLACEMENT TEMPERATURE OF 59°F. (41°C). THE SUPPLY FAN WILL, BE RECHARGED, PLACEMENTS GO

Anchor Bay School District Transportation Center

51890 Washington, New Baltimore, MI 48047

SYSTEM

BLOWER COIL UNIT CONTROL WIRING DIAGRAM

LAN ADDRESS 01

CT CONTROLLED TEMPERATURE INC.

1897 WEST DRIVE, WALLED LAKE MICH 48090 TEL. (248) 649-0500

FILE NAME: J05ANCHOR BAY SCHOOL TRANSPORTATION CENTER-VC-1-LOGIC.dwg


DRAWN BY: KOS DATE: 03/27/03


JOB NO: 02-304

ASBULL: 07/24/03

04B

INCLUDE IN BASE BID

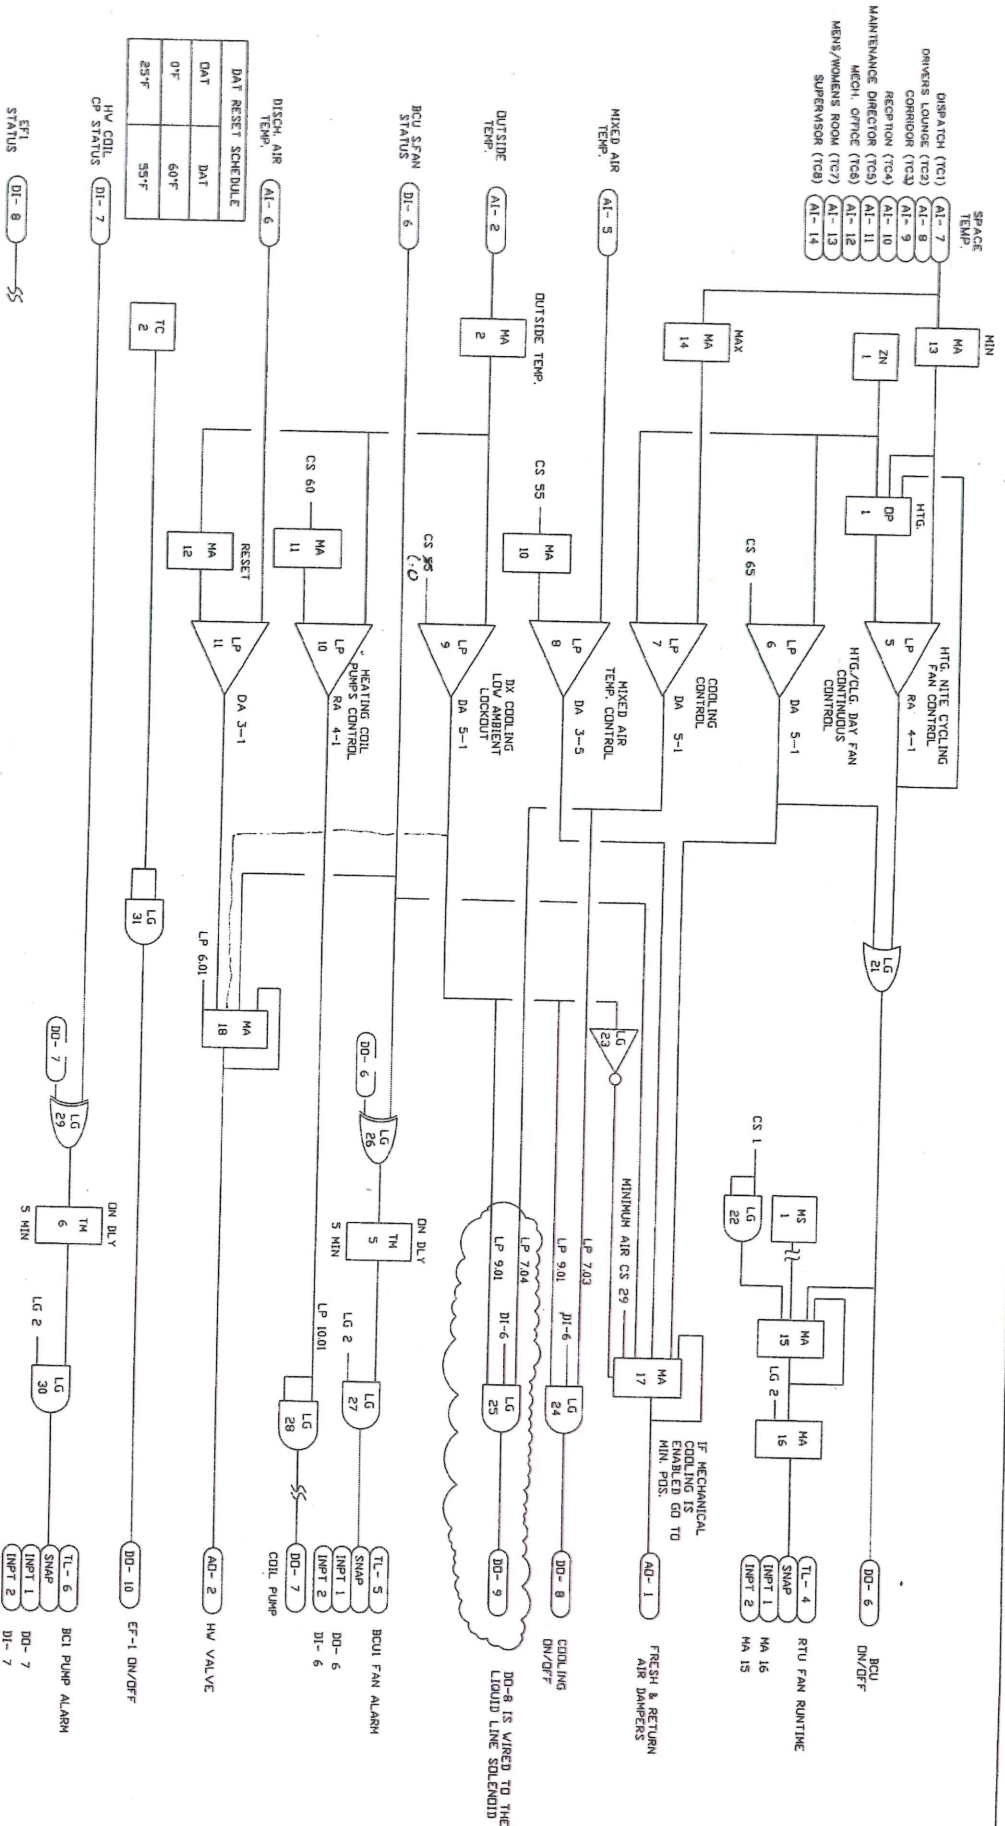

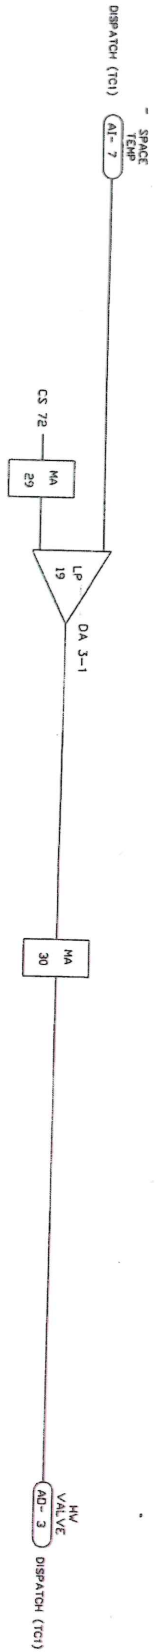

TC	NUMBER	ANALOG INPUT	SETPOINT	LODP	CONTROL	ANALOG OUTPUT
DISPATCH (TC1)	TC1	7	29	19	30	3
DRIVERS LOUNGE (TC2)	TC2	8	31	20	32	4
CORRIDOR (TC3)	TC3	9	33	21	34	5
RECEPTION (TC4)	TC4	10	35	22	36	6
MAINTENANCE DIRECTOR (TC5)	TC5	11	37	23	38	7
MECH. OFFICE (TC6)	TC6	12	39	24	40	8
MENS/WOMENS ROOM (TC7)	TC7	13	41	25	42	9
SUPERVISOR (TC8)	TC8	14	43	26	44	10

INCLUDE IN BASE BID

Anchor Bay School District
Transportation Center

51090 Washington, New Baltimore, MI 48047

SYSTEM

BC-1 REHEAT LOGIC DIAGRAM

LAN ADDRESS 01

CT CONTROLLED TEMPERATURE INC.

1897 BEST DRIVE, WALTON LANE HIGH 48390 TEL. (248) 669-0500

FILE NAME: J005\ANCHOR BAY SCHOOL TRANSPORTATION CENTER\BC-1 RH LOGIC.dwg

DRAWN BY: KDS

DATE: 07/07/03

JOB NO: 02304

ASBUIL: 10/17/24/03

04C



PAGE NUMBER

Anchor Bay School District Transportation Center

SYSTEM
BLOWER COIL UNIT 2 CONTROL WIRING DIAGRAM


CT CONTROLLED TEMPERATURE INC.
1897 WEST DRIVE, VALLEY LANE HIGH 48390 TEL. (248) 669-0500
FILE NAME: J035-ANCHOR BAY SCHOOL TRANSPORTATION CENTER-DC-248g
DRAWN BY: KAS DATE: 07/02/03 JOB NO: 02304 AS BUILT: 07/24/03

INCLUDE IN BASE BID

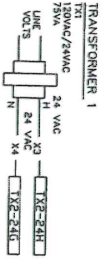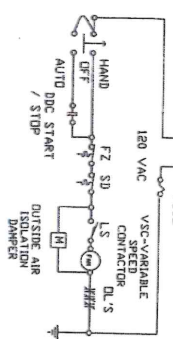

SUPPLY FAN STARTER WIRING

1. WITH THE SUPPLY HAND/OFF/AUTO SWITCH IN THE "AUTO" POSITION, THE BLOWER COIL UNIT WILL BE TO RUN CONTINUOUSLY.
2. WHEN THE CONTROL CIRCUIT OF THE BLOWER COIL UNIT SUPPLY FAN IS ENERGIZED TO START THE SUPPLY FAN, THE DISCHARGE AIR TEMPERATURE SENSOR WILL BE PROVIDED TO THE DDC SYSTEM BY MEANS OF THE SUPPLY FAN MOTOR CURRENT SWITCH. THEN AN ALARM WILL BE SENT TO THE DDC SYSTEM INDICATING A BLOWER COIL UNIT FAILURE.
3. THE BLOWER COIL UNIT SUPPLY FAN RUN/OFF STATUS WILL BE PROVIDED TO THE DDC SYSTEM BY MEANS OF THE SUPPLY FAN MOTOR CURRENT SWITCH. THEN AN ALARM WILL BE SENT TO THE DDC SYSTEM INDICATING A BLOWER COIL UNIT FAILURE.
4. THE DISCHARGE AIR TEMPERATURE SENSOR THROUGH DDC WILL MODULATE THE HEATING COIL. THE DDC VALVE TO MAINTAIN THE DISCHARGE AIR TEMPERATURE SETPOINT. THE DISCHARGE AIR TEMPERATURE SENSOR WILL BE PROVIDED TO THE DDC SYSTEM BY MEANS OF THE SUPPLY FAN MOTOR CURRENT SWITCH. THEN AN ALARM WILL BE SENT TO THE DDC SYSTEM INDICATING A BLOWER COIL UNIT FAILURE.
5. THE HOT WATER HEATING COIL CIRCULATING PUMP MOTOR STARTER HAND/OFF/AUTO SWITCH WILL BE PLACED IN THE "AUTO" POSITION.
6. WHEN THE OUTSIDE AIR TEMPERATURE IS 55°F OR BELOW (ADD), THE HEATING COIL CIRCULATING PUMP WILL BE ENERGIZED AND THE HEATING COIL CIRCULATING PUMP WILL BE PROVIDED TO THE DDC SYSTEM BY MEANS OF ITS PUMP MOTOR CURRENT SWITCH. THEN AN ALARM WILL BE SENT TO THE DDC SYSTEM INDICATING A BLOWER COIL UNIT FAILURE.
7. THE HEATING COIL CONTROL VALVE WILL BE MODULATED BY THE DISCHARGE AIR TEMPERATURE SENSOR TO MAINTAIN A LOW LIMIT PLUCHON TEMPERATURE OF 50°F.
8. IF SMOKE IS DETECTED IN THE AIR STREAM BY A SMOKE DETECTOR OF THE SETPOINT OF A FREEZE/STAT SETPOINT IS REACHED.
9. THE FILTER DIFFERENTIAL PRESSURE SWITCH WILL ISSUE A BIRTY FILTER ALARM TO THE DDC IF ITS SETPOINT IS REACHED.
10. IF THE BLOWER COIL UNIT SUPPLY FAN IS DE-ENERGIZED, THE OUTSIDE AIR BLOWER WILL FULLY CLOSE, THE HEATING COIL CONTROL VALVE WILL BE MODULATED BY THE DISCHARGE AIR TEMPERATURE SENSOR TO MAINTAIN A LOW LIMIT PLUCHON TEMPERATURE OF 50°F.

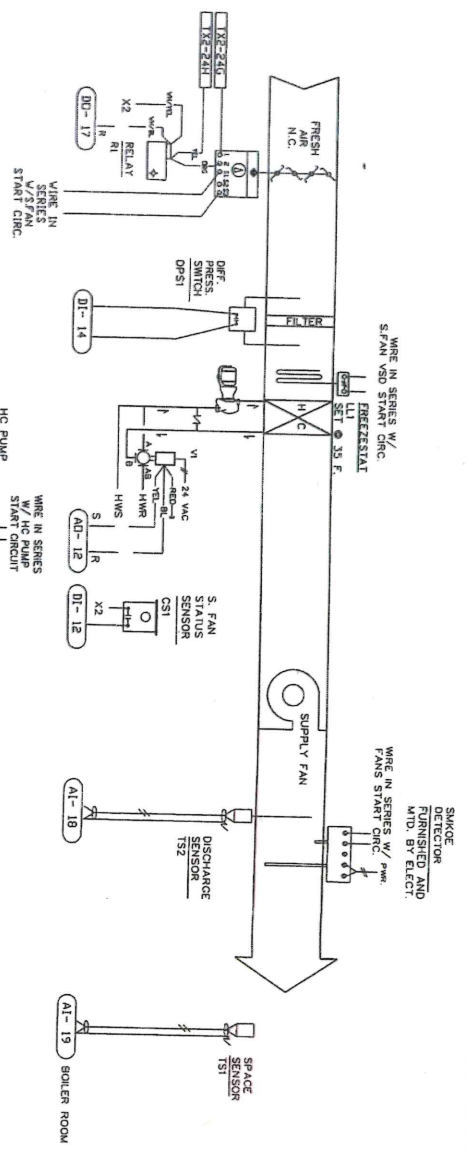

BILL OF MATERIALS				
ITEM	QTY.	PART NUMBER	DESCRIPTION	UNIT
CS12	2	H-708	HEATING COIL UNIT	VA
CS12	2	AT-245	2-POS. DIRECT COUPLED DAMPER ACTUATOR	141
DL1	1	TC-5241	LOW TEMPERATURE THERMOSTAT N/R	INVERT
DL1	1	PC-301	0-1" STATIC PRESSURE SWITCH	INVERT
DL1	2	V100	SPDT RELAY IN A BOX V/OVER-RIDE SV	0.8
DL1	1	15001	PROVIDED BY OTHERS	INVERT
DL1	1	15001	SPACE TEMPERATURE SENSOR	INVERT
DL1	1	15001	DUCT TEMPERATURE SENSOR	INVERT
DL1	1	15001	120/240VAC TRANSFORMER, V/BREAKER	50
DL1	1	15001	24VAC/0-10VDC/PROP-3-VAN MIXING VALVE	18
DL1	1	15001	24VAC/0-10VDC/PROP-3-VAN MIXING VALVE	18

Anchor Bay School District Transportation Center

SYSTEM

BLOWER COIL UNIT 2 CONTROL LOGIC DIAGRAM

LAN ADDRESS 01

SERVES THE BOILER ROOM


CT CONTROLLED TEMPERATURE INC.

1897 BEST DRIVE, VALLEY LAKE ILL. 60089 TEL. (248) 669-0300

FILE NAME: J055ANCHOR BAY SCHOOL TRANSPORTATION CENTER BC-2 LOGIC.DWG
DRAWN BY: KDS DATE: 07/07/03 JOB NO: 02304

ASBULL 07/24/03

05B
PAGE NUMBER

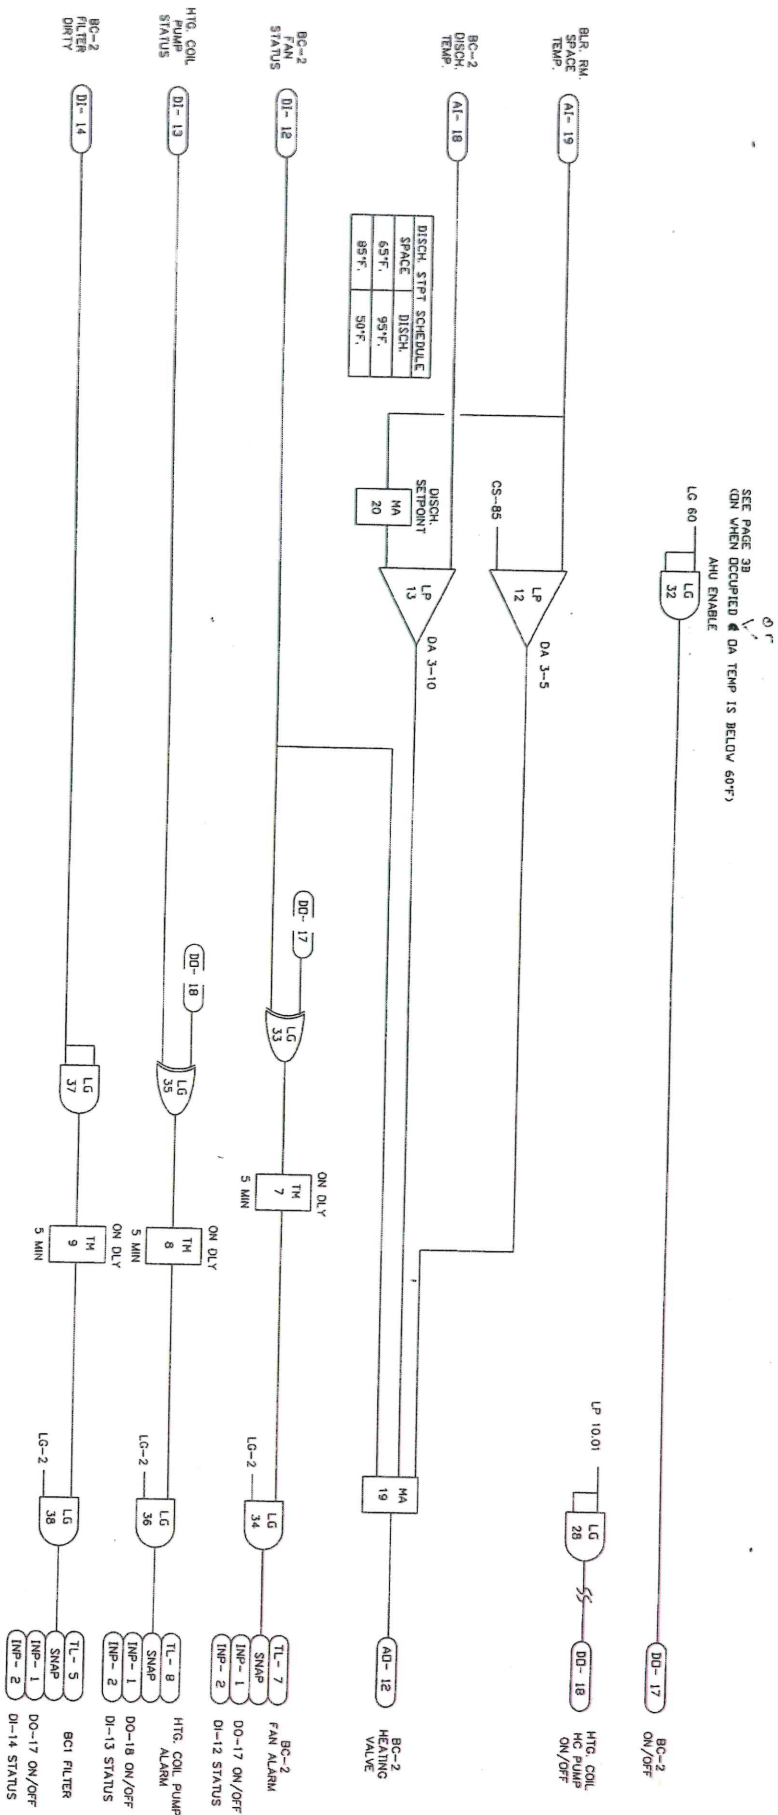


INCLUDE IN BASE BID

51090. Washington, New Baltimore, MI 48047

LAN ADDRESS 01

FILE NAME: I35VANCHUB DAY SCIENCE & TECHNOLOGY, INC. 007-0000

PAGE NUMBER

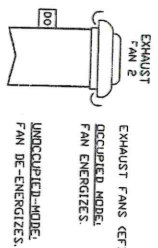

ITEM	QTY.	PART NUMBER	DESCRIPTION	VA	MAINT.
CS-3	3	H-700	HAWKLEY CURRENT SENSING SWITCH	INVS	INVS
LL-1	1	TC-52-4	LOW TEMPERATURE THERMOSTAT M/R	INVS	INVS
SP-2	2	V100	SPD RELAY IN A BOX	0.6	VERIS
TS-1	1		PROVIDED BY OTHERS		
TS-2	1	TS-8010	SPACE TEMPERATURE SENSOR	INVS	INVS
TS-3	1	TS-8010	SPACE TEMPERATURE SENSOR	INVS	INVS
TK-1	1	AI10001022	TRANS DMMR V/B REGRAND	50	JCL
V-1	1	V27313-201-4-96	2-WAY 1/2" DIA. 3-WAY MIXING VALVE	INVS	INVS
DM-1	1	AF-24-SF	PAWR, DIRECT COUPLED DMMER ACTUATOR	14.7	BEHND

1. WHEN DISCONNECT SWITCH IS IN THE "ON" POSITION: THE UNIT IS ENERGIZED, THE EXHAUST FAN IS ENERGIZED AND THE EXHAUST GRANTY DAMPER OPENS, THE OUTSIDE AIR FACE DAMPER OPENS, WHEN THE DAMPER OPENS THE SUPPLY FAN IS ENERGIZED. WHEN THE DISCONNECT SWITCH IS "OFF": SUPPLY AND EXHAUST FANS ARE DE-ENERGIZED, OUTSIDE AIR AND EXHAUST AIR DAMPERS CLOSE.

2. (HEAT EXCHANGER) OUTSIDE AIR FACE & BYPASS DAMPER SEQUENCE
- A PROPORTIONAL/INTEGRAL CONTROLLER WILL BE MOUNTED IN THE CONTROL PANEL. THE CONTROLLER WILL HAVE A DEFROST SENSOR MOUNTED IN THE EXHAUST AIR STREAM LEAVING THE HEAT EXCHANGER AND AN ECONOMIZER SENSOR MOUNTED IN THE OUTSIDE AIR STREAM ENTERING THE HEAT EXCHANGER.

3. WINTER DEFROST MODE (EXHAUST AIR TEMPERATURE LEAVING HX BELOW 33°F.)

- THE CONTROLLER WILL MODULATE THE FACE/BYPASS DAMPERS TO PREVENT THE EXHAUST AIR STREAM TEMPERATURE FROM DROPPING BELOW 33°F. THE BYPASS DAMPER MODULATES OPEN AND THE FACE DAMPER MODULATES CLOSED TO PREVENT FROSTING ON THE HEAT EXCHANGER.

4. WARMER ENERGY RECOVERY MODE (EXHAUST LEAVING AIR TEMPERATURE ABOVE 33°F. AND OUTSIDE AIR TEMPERATURE BELOW 70°F)
FACE DAMPER FULL OPEN, BYPASS DAMPER FULL CLOSED. ALL OUTSIDE AIR PASSES THROUGH THE HEAT EXCHANGER.

5. ECONOMIZER MODE (OA TEMPERATURE ABOVE 70°F. AND BELOW 80°F.)
FACE DAMPER FULL CLOSED, BYPASS DAMPER FULL OPEN. OUTSIDE AIR IS BYPASSED AROUND THE HEAT EXCHANGER.

- FACE DAMPER FULL OPEN, BYPASS DAMPER FULL CLOSED. ALL OUTSIDE AIR PASSES THROUGH THE HEAT EXCHANGER.

- THE DOG SYSTEM WILL MODULATE THE HEATING COIL CONTROL VALVE TO MAINTAIN A SPACE TEMPERATURE SETPOINT OF 72°F. (ADJUSTABLE) OCCUPIED MODE, AND A SPACE TEMPERATURE SETPOINT OF 88°F. (ADJUSTABLE) UNOCCUPIED MODE. AN OPTIMIZER PROGRAM WILL DETERMINE HOW LONG IT TAKES TO GET THE SPACE TEMPERATURE TO SETPOINT PRIOR TO OCCUPANCY.

- HEATING COIL. LOW LIMIT THERMOSTAT WILL PREVENT THE FAN FROM OPERATING WHEN THE COIL TEMPERATURE FALLS BELOW ITS SETPOINT. ONCE TRIPPED, THIS DEVICE MUST RESET BEFORE THE FAN OPERATION WILL RESUME OPERATION. DUCT SMOKE DETECTOR. WHEN FAN OPERATION HAS PARTICLES OF COMBUSTION ARE DETECTED IN THE AIRSTREAM, PROVIDE CURRENT SENSOR ON HEATING COIL PUMP TON PROTECTION TO SHUT DOWN AHU AND CLOSE OUTSIDE AIR DAMPER.

INCLUDE IN BASE BID

51890 Washington, New Baltimore, MI 48047

ENERGY RECOVERY UNIT CONTROL LOGIC DIAGRAM

1897 BEST DRIVE, VALLED LAKE MICH. 48390 TEL. (248) 669-0500


06B

DRAWN BYKDS DATE:07/07/03 INB MD02304 LOGIC:dwg


DATE:07/07/03 JOB ND:02.304

ASBUIL T107/24/0


PAGE NUMBER

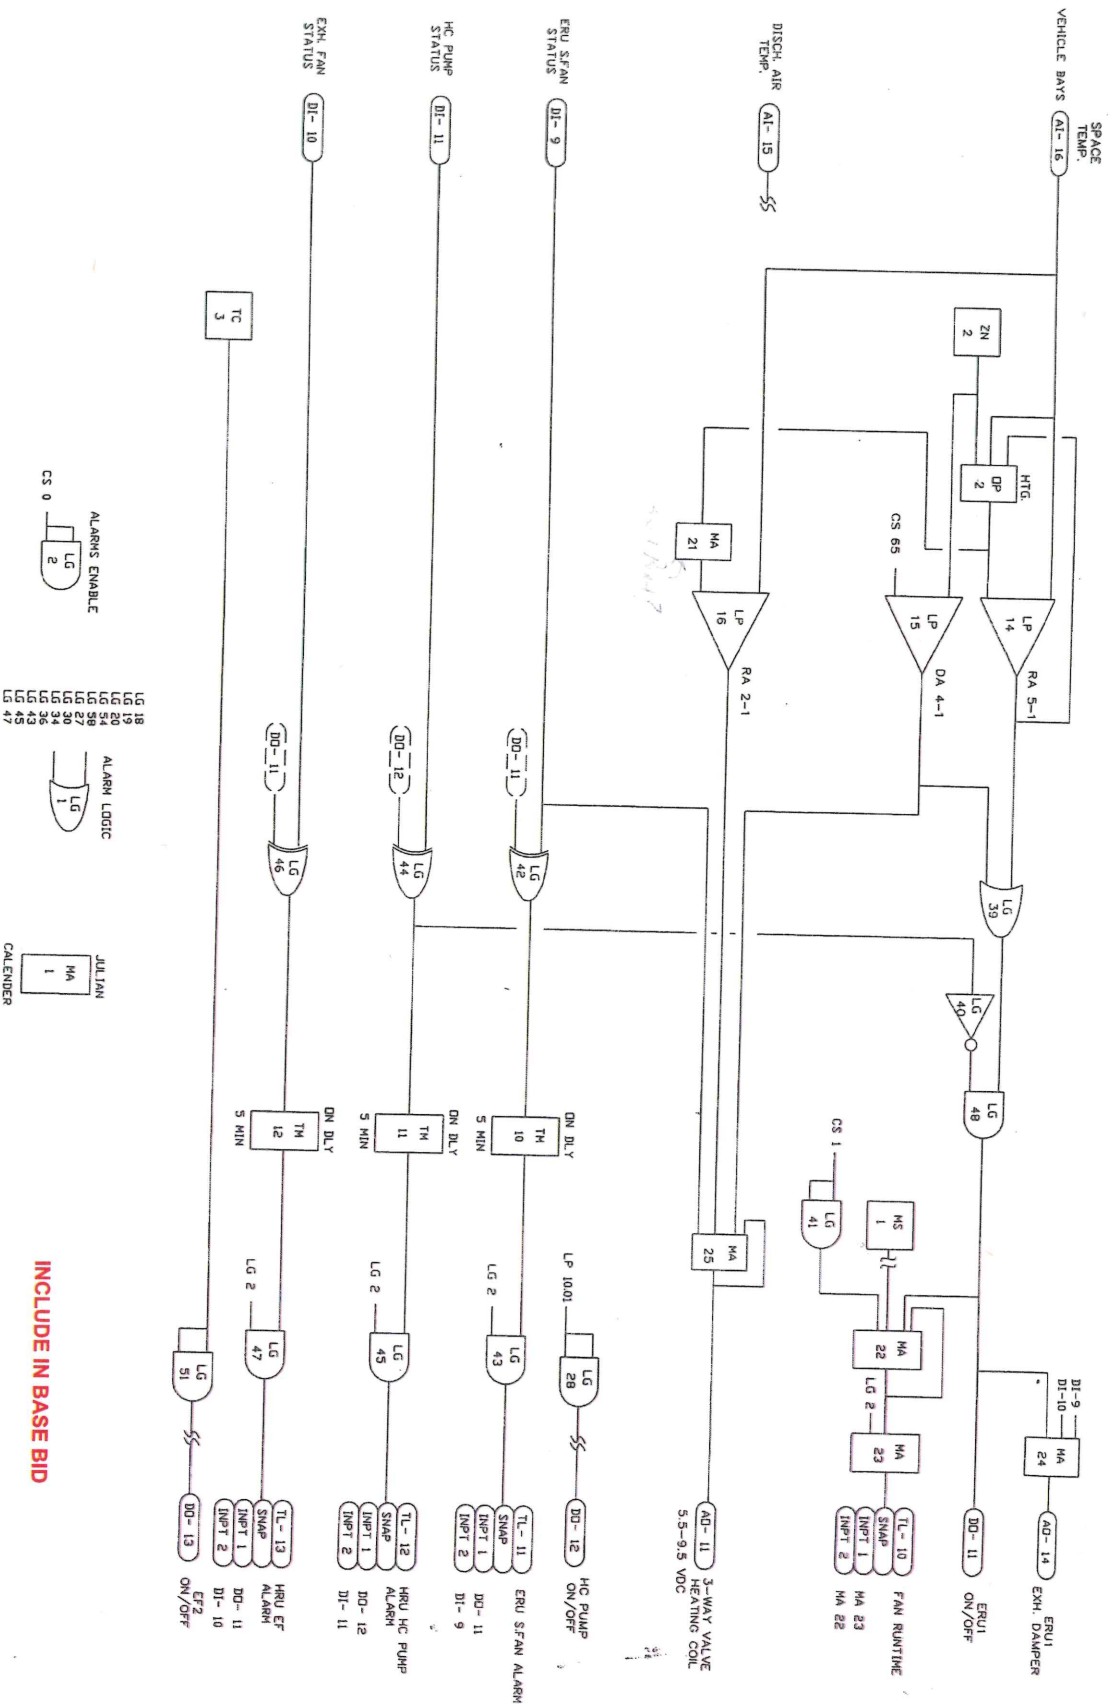

BILL OF MATERIALS					
ITEM	QTY	PART NUMBER	DESCRIPTION	VA	MANUF.
AD 1	1	TC2974	ADJUSTAT	--	INVERTEK
RI-3	3	R8239B1043	FAN CENTER	0.8	INVERTEK
BN-2	2	AF 245	2-POSITION DIRECT COUPLED ACTUATOR	14	INVERTEK
TS 1	1	TS-8101	120/24VAC TRANSFORMER W/BREAKER	50	INVERTEK
VI 1	1	VA1313-201-4-02	24VAC 2-POS 3-WAY MIXING VALVE	18	INVERTEK

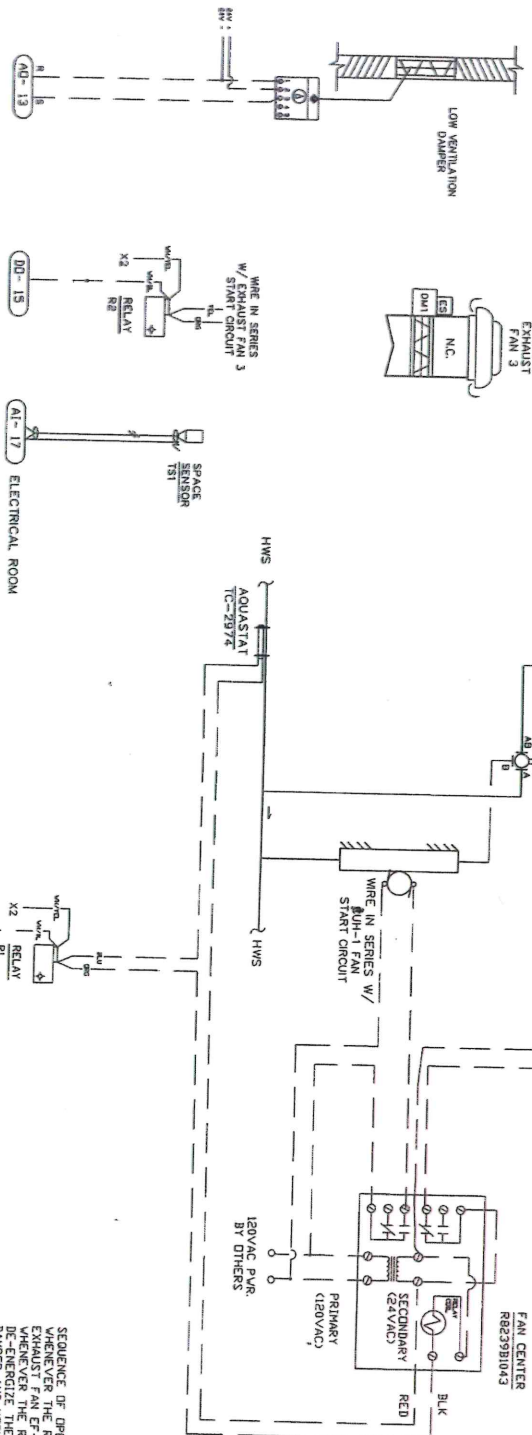

SEQUENCE OF OPERATION:
WHENEVER THE ROOM TEMPERATURE RISES ABOVE 80°F (AND) THE T-SENSOR WILL START EXHAUST FAN EF-3. OPEN THE ROOF EXHAUST DAMPER AND T-SENSOR WILL START DAMPER. WHEN THE ROOM TEMPERATURE DROPS BELOW 80°F, THE T-SENSOR WILL SHUT OFF THE EXHAUST FAN AND DAMPER. WHENEVER THE ROOM TEMPERATURE RISES ABOVE 80°F (AND) THE T-SENSOR WILL START EXHAUST FAN EF-3. OPEN THE ROOF EXHAUST DAMPER AND T-SENSOR WILL START DAMPER. WHEN THE ROOM TEMPERATURE DROPS BELOW 80°F, THE T-SENSOR WILL SHUT OFF THE EXHAUST FAN AND DAMPER. WHENEVER THE ROOM TEMPERATURE RISES ABOVE 80°F (AND) THE T-SENSOR WILL START EXHAUST FAN EF-3. OPEN THE ROOF EXHAUST DAMPER AND T-SENSOR WILL START DAMPER. WHEN THE ROOM TEMPERATURE DROPS BELOW 80°F, THE T-SENSOR WILL SHUT OFF THE EXHAUST FAN AND DAMPER.

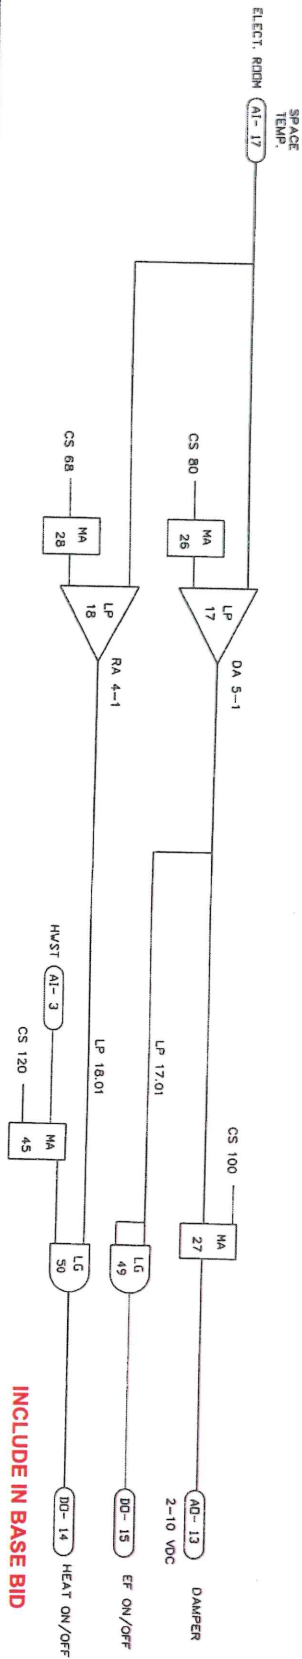

INCLUDE IN BASE BID

Anchor Bay School District
Transportation Center


SYSTEM
ELECTRICAL ROOM VENTILATION CONTROL WIRING DIAGRAM

CT CONTROLLED TEMPERATURE INC.
1897 WEST DRIVE, WALKER LAKE MOH 48390 TEL (248) 665-0000


51890 Vashington, New Baltimore, MI 48047

FILE NAME: JDS\ANCHOR BAY SCHOOL\TRANSPORTATION CENTER\ELECTRICAL ROOM VENT.dwg
DRAWN BY: JDS DATE: 05/19/03 JOB NO: 002304 ASUILT07/24/03 PAGE NUMBER 07

CUH WIRING DIAGRAM

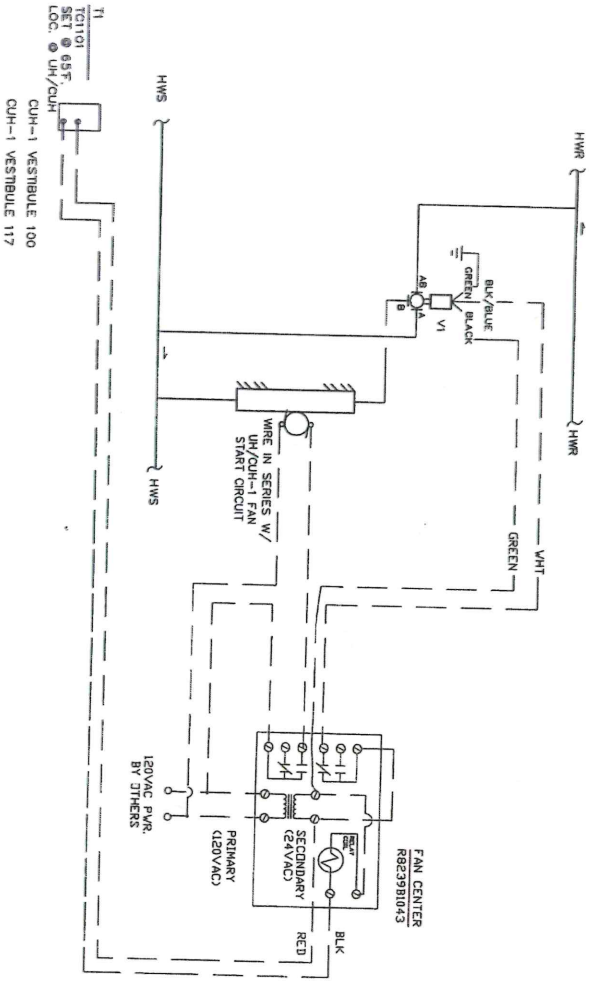

GAS FIRED INGRA-RED TUBE HEATER WIRING DIAGRAM

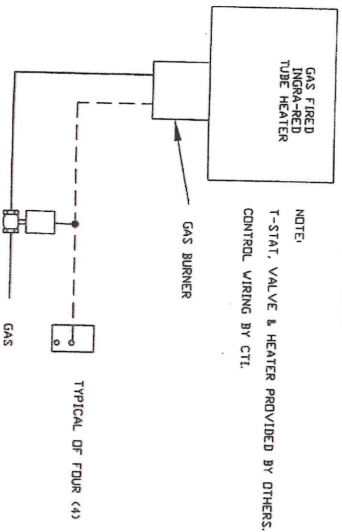


BILL OF MATERIALS

ITEM	QTY.	PART NUMBER	DESCRIPTION	VA	MANUF.
FC	2	R8239B1043	FAN CENTER	--	INVTWELL
T1	2	T1010	LINE VOLTAGE THERMOSTAT	--	INVTWELL
TA	2	A1150P1082	120/24VAC TRANSFORMER, V/BREAKER	50	INVTWELL
V1	2	VA7315-201-4-02	24VAC-2-POS-3-WAY MIXING VALVE	18	INVTWELL

SEQUENCE OF OPERATION:

UPON A CALL FOR HEATING FROM THE ROOM T-STAT THE HWS COIL CONTROL VALVE WILL OPEN AND THE CABINET UNIT HEATER FAN WILL BE COOLED. WHEN THE ROOM T-STAT SETPOINT IS REACHED, THE HWS COIL CONTROL VALVE WILL CLOSE AND THE CABINET UNIT HEATER FAN WILL BE CYCLED OFF.

VEF WIRING DIAGRAM

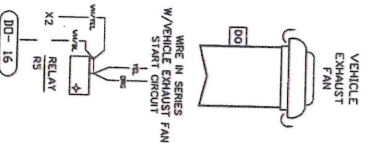

INCLUDE IN BASE BID

Anchor Bay School District
Transportation Center

31090 Washington, New Baltimore, MI 48047

SYSTEM
CABINET UNIT HEATER & VEF CONTROL WIRING DIAGRAM
LAN ADDRESS 01

CTI CONTROLLED TEMPERATURE INC.
1897 BEST DRIVE, WALLED LAKE MICH 48090 TEL (248) 669-0500

FILE NAME: J055ANCHOR BAY SCHOOL TRANSPORTATION CENTER.DWG VEF.dwg
DRAWN BY: KDS DATE: 05/19/03 JOB NO: 002304 ASBUILT: 07/24/03

08

PAGE NUMBER

